

MICHIGAN  
DEPARTMENT OF CONSERVATION  
FORESTRY DIVISION

# LAND CORNER RECORD

T. 41N N.R. 7E


Chippewa COUNTY

DESCRIPTION OF CORNER Meander Corner bet. Secs. 12-13 on shore of Lake Huron

CORNER MONUMENT 1" pipe with 4" aluminum cap

DATE MONUMENT PLACED AND WITNESSED 8-21-69

WITNESSES TO CORNER..... 24" Cedar (NBT) S18°W 20.5'

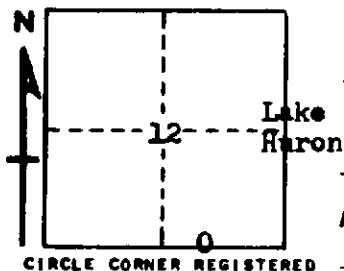

12" Cedar (NBT) N38°W 21.3'

9" Bp Spruce (NBT) S85°W 16.7'

AND

CIRCLE CORNER REGISTERED

DESCRIPTION IN DETAIL AS TO HOW CORNER WAS LOCATED AND IDENTIFIED OR RESTORED.

This corner re-witnessed as placed by unknown persons. Found an old wood post and pile of stones, on edge of timber. Position checks with record meanders of lake shore.

SURVEYOR'S SEAL

SIGNED Billy D. Buckler DATE 3-2-70  
REGISTERED LAND SURVEYOR