

MICHIGAN
DEPARTMENT OF CONSERVATION
FORESTRY DIVISION

LAND CORNER RECORD

T. 41N N. R. 7E

Chippewa COUNTY


DESCRIPTION OF CORNER Sec. Cor. common to Secs. 13-14-23-24

CORNER MONUMENT 1" pine with 4" aluminum cap.

DATE MONUMENT PLACED AND WITNESSED 8-5-70

WITNESSES TO CORNER..... 9" Cedar (S23 NBT) S62°W 36.6'

17" Cedar (S24 NBT) S28°E 48.5'

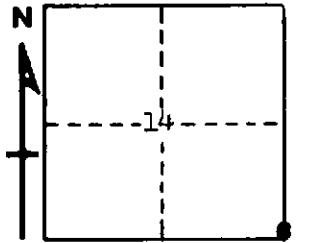

AND

CIRCLE CORNER REGISTERED

DESCRIPTION IN DETAIL AS TO HOW CORNER WAS LOCATED AND IDENTIFIED OR RESTORED.

This corner replaced from one possible witness tree, a down cedar, bearing N35°W, 22 links.

Found a few blazes to North and West of the corner. Distance North and East to lake is possibly longer than record.

SURVEYOR'S SEAL

SIGNED *Billy D. Buckler*
Billy D. Buckler
REGISTERED LAND SURVEYOR

DATE 8-27-70