

LAND CORNER RECORDATION CERTIFICATE

FILING REQUIREMENT OF ACT 74, MICH. P.A.1970
Chippewa Co. 4 Corners.

FOR CORNERS OF- LOCATED IN- CORNER CODE NUMBER
1. PUBLIC LAND SURVEY T. 42 N. S. R. 2 E. W. G-10, D-9, G-9, D-5
2. PROPERTY CONTROLLING IN SECTION T. S. R. E. W.
3. MISCELLANEOUS PROPERTY IN SECTION T. S. R. E. W.
4. LOT NO. , RECORDED PLAT
5. PRIVATE CLAIMS

REGISTER OF DEEDS STAMP AND FILING NUMBER

I, Billy D. Buckler, do hereby certify that under requirements of P.A. 74, Michigan P.A. of 1970, the corner points mentioned in lines 1 and 2 above were, in a field survey on 9-6, 1979, established, re-established, monumented, re-monumented, recovered or restored as expressed below and in conformance with regulations and rules therefore as required in the current manual of survey instructions of the United States Department of the Interior, Bureau of Land Management or by a decree of a court of law. Furthermore, that the corner points mentioned in lines 3, 4 and 5 above were, in a field survey on, 19, found, recovered, restored, established or re-established as expressed below and in conformance with the rules of the Michigan State Board of Registration for Land Surveyors or, by a Decree of a Court of law:

A. Description of original monument and accessories and/or subsequent restoration: Corners set by John Bullett, D.S. in 1845.

- G-10 1/4 Cor. bet. Sec's. 27-28, bearings were: Hem. 12", N54°W, 9 lks. & Sugar 10", S28°E, 27 lks.
D-9 1/4 Cor. bet. Sec's. 20-29, bearings were: Fir 12" for corner.
G-9 Sec. Cor. 21-22-27-28, bearings were: Sugar 20", N50°E, 22 lks. & Sugar 14", S14°W, 28 lks.
D-5 1/4 Cor. bet. Sec's. 8-17, bearings were: Sugar 10", N18°W, 18 lks. & Sugar 6", S25°E, 17 lks.

B. Description of corner evidence found and/or method applied in restoring or re-establishing corner:


- G-10 Corner restored midway and on line bet. two. Sec. Cors. Found no evidence of original cor.
D-9 Restored corner midway bet. two section corners.
G-9 Placed section corner by double prop. measure. Checks well to corners in all four direction
D-5 Placed 1/4 corner bet. two section corners. Found no evidence of original corner.

C. Description of monument for corner and accessories established to perpetuate locating the position of the corner:

Placed 1" pipe with 4" aluminium cap at all corners.

- G-10 New Bearings: 6" Sugar, N84°W, 22.2' & 8" Sugar, S28°W, 28.5' & 6" Sugar, S54°E, 23.0'
D-9 New Bearings: 10" Cedar, S64°E, 19.3' & 8" Cedar, N86°W, 19.5' & 8" Cedar, N35°E, 29.4'
G-9 New Bearings: 14" Sugar, N40°E, 6.4' & 8" Sugar, S8°W, 49.7' & 10" Sugar, S60°W, 35.9'
24" Sugar, Blazed 3 sides, N10°E.
D-5 New Bearings: 18" Sugar, S53°E, 10.3' & 6" Sugar, N89°W, 33.0' & 10" R. Maple, S1°E, 67.1

SIGNED BY Billy D. Buckler DATE 9-21-79
Billy D. Buckler
SURVEYOR'S MICHIGAN REGISTRATION NO. 8887

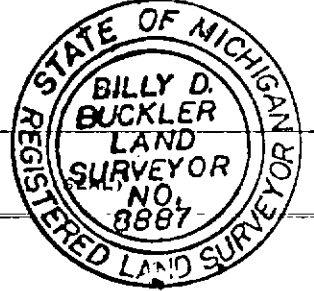

FOR STATE AND UNITED STATES AGENCIES:

SIGNED BY CHIEF OF SURVEY PARTY DATE

APPROVED AND SIGNED BY MICHIGAN REGISTERED LAND SURVEYOR DATE

SURVEYOR'S MICHIGAN REGISTRATION NO.