

LAND CORNER RECORDATION CERTIFICATE

FILING REQUIREMENT OF ACT 74, MICH. P.A.1970
Chippewa Co. 4 Corners.

FOR CORNERS OF--	LOCATED IN--	CORNER CODE NUMBER
1. PUBLIC LAND SURVEY	T. <u>42</u> N. <u>2</u> E. <u>X</u> S. R. <u>2</u>	<u>E-10, F-9, K-11</u>
2. PROPERTY CONTROLLING IN SECTION	<u>26</u> , T. <u>42</u> N. <u>2</u> E. <u>X</u> S. R. <u>2</u>	<u>2-Sec.26</u>
3. MISCELLANEOUS PROPERTY IN SECTION	T. _____ N. _____ E. _____ S. R. _____ W. _____	_____
4. LOT NO. _____, RECORDED PLAT _____		
5. PRIVATE CLAIMS _____		

REGISTER OF DEEDS STAMP AND FILING NUMBER

I, Billy D. Buckler, do hereby certify that under requirements of P.A. 74, Michigan P.A. of 1970, the corner points mentioned in lines 1 and 2 above were, in a field survey on 7-18 & 10-5, 19 79, established, re-established, monumented, re-monumented, recovered or restored as expressed below and in conformance with regulations and rules therefore as required in the current manual of survey instructions of the United States Department of the Interior, Bureau of Land Management or by a decree of a court of law. Furthermore, that the corner points mentioned in lines 3, 4 and 5 above were, in a field survey on _____, 19____, found, recovered, restored, established or re-established as expressed below and in conformance with the rules of the Michigan State Board of Registration for Land Surveyors or, by a Decree of a Court of law:

A. Description of original monument and accessories and/or subsequent restoration:

Sec. Cor. & 1/4 Cors. set by John Mullett, D.S. in 1845. Bearings were:

- E-10 1/4 Cor. bet. Sec's. 28-29: Sugar 7, S88°E, 19 lks. & Sugar 8, S81°W, 6 lks.
- F-9 1/4 Cor. bet. Sec's. 21-28: W. Birch 6, N80°W, 10 lks. & Fir 7, S68°E, 4 lks.
- K-11 Sec. Cor. 25-26-35-36: W. Birch 6, S3°E, 3 lks. & W. Birch 8, N45°W, 21 lks.
- 2-Sec.26 East 1/16 Corner, on North side of Section 26.

B. Description of corner evidence found and/or method applied in restoring or re-establishing corner:


- E-10 Restored corner midway and on line between two section corners.
- F-9 Restored corner midway and on line between two section corners.
- Restored corner from corners in all four directions. Found no evidence of original corner. (K-11)
- 2-Sec.26 Placed corner midway bet. 1/4 corner to West and Sec. Cor. to East.

C. Description of monument for corner and accessories established to perpetuate locating the position of the corner:

Placed 1" pipe with 4" aluminium cap at all corners. Bearings are:

- E-10 18" Soft Maple, N10°W, 28.3' & 8" Cedar, S62°W, 15.7' & 7" Cedar, S55°E, 53.2'.
- F-9 8" Soft Maple, N5°W, 13.9' & 6" S. Maple, S65°E, 17.7' & 6" S. Maple, S32°W, 6.2' & Large Boulder, N15°E, 13.5'. Corner lies on South side & midway of large ridge.
- K-11 4" W. Birch, S53°W, 10.9' & 8" Aspen, N4°E, 31.4' & 8" Aspen, S13°E, 38.1'.
- 2-Sec.26 7" Aspen, N66°W, 3.4' & 14" Spruce, S71°E, 33.5' & 8" Spruce, S43°E, 20.2'.
pipe is leaning over a large flat stone.

SIGNED BY _____ DATE 3-5-80
Billy D. Buckler
SURVEYOR'S MICHIGAN REGISTRATION NO. 8887

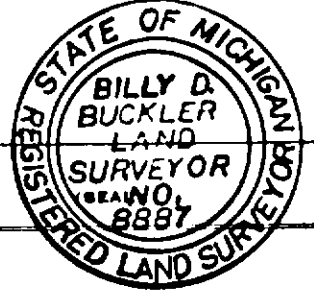

FOR STATE AND UNITED STATES AGENCIES:

SIGNED BY _____ DATE _____
CHIEF OF SURVEY PARTY
APPROVED AND SIGNED BY _____ DATE _____
MICHIGAN REGISTERED LAND SURVEYOR (SEAL)

SURVEYOR'S MICHIGAN REGISTRATION NO. _____