

LAND CORNER RECORDATION CERTIFICATE
Filing Requirement of Act 74, Mich. P.A. 1970 as Amended

For corners in


<u>Chippewa</u> (County)	Located In:	Corner Code #
1. Public Land Survey	T <u>42N</u> R <u>2E</u>	<u>A3</u>
	T _____ R _____	_____
	T _____ R _____	_____
2. Property Controlling in Section	S _____ T _____ R _____	_____
	S _____ T _____ R _____	_____
3. Miscellaneous Property in Sec.	S _____ T _____ R _____	_____
	S _____ T _____ R _____	_____

Register of Deeds Stamp & File Number

4. Lot No. _____, Recorded Plat _____
 5. Private Claims _____

Aug 12 2005

I, Stephan J. Szyszkoski, in a field survey on _____, 20____ do hereby state that under requirements of P.A. 74, Michigan P.A. of 1970, the corner points mentioned in lines 1 and 2 above were in conformance with regulations and rules therefore as required in the current manual of survey instructions of the United States Department of the Interior, Bureau of Land Management or by a decree of a Court of Law and /or that the corner points mentioned in lines 3, 4 and 5 above were in conformance with the rules of the Michigan Board of Land Surveyors or by a Decree of a Court of Law; established, re-established, monumented, recovered, found as expressed below:

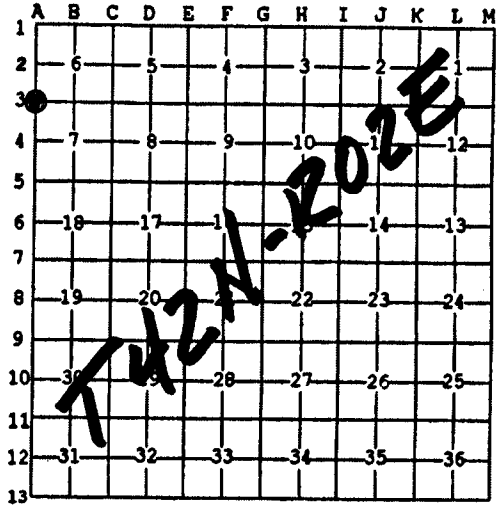

NOTE: Not more than 2 corners, all in the same town and range, may be recorded on this certificate.

A. Description of original monument and accessories and/or subsequent restoration:


(A3) Corner common to Sections 6-7 T42N-R02E and Sections 1-12, T42N-R01E. 1840 - Established by Austin Burt, Deputy Surveyor: South on East side of Section 1 ...80.00 Set post corner of Sections 1 & 12 Cedar 20 S20W 11 links, Cedar 20 N10W 11 links. ...South on East side of Section 12 ...80.00 Fir 4 corner of Section 12 & 13. 1987 - LCRC filed by Wm. L. Karr PS in C-245 Mackinac County Records states "Found no evidence of original corner. Found cedar post. Accepted corner position as found. Corner is a cedar post". Ties: 8" Cedar S52E 38.54', 12" Spruce S24W 24.95', 10" Cedar N25W 37.58', 14" Cedar N23E 47.18'.

B. Description of corner evidence found and/or method applied in restoring or reestablishing corner:

(A3) The original post and accessories were not recovered. Recovered a 1" o.d. iron pipe with plastic cap "MLK 27450" conforming to the 1987 record. Continued examination of the position of this monument revealed that it is located approximately N3W (true) 130' from the proportionate position of record which was subsequently monumented by the undersigned. Discussion with Mr. Karr led to the mutual judgement that the 1987 monument of record did not best represent the position of the original corner and it was decided to reestablish the corner by proportionate measurement to the original record. Accordingly, the corner was reestablished on a straight line between monumented Quarter corner A2 2637.87' north and monumented Section corner A5 5275.74' south. The pipe and post marking the 1987 position were removed.

C. Description of monument for corner and accessories established to perpetuate locating the position of the corner:

(A3) Set 1" IDx36" I.pipe with 4" alum. MDNR cap. Set measuring nails in:
 9" Cedar N68W 8.65' mrkd "S1 NBT"
 17" Cedar S60W 11.7' mrkd "S12 NBT"
 12" W.Birch S10E 12.6' mrkd "S7 NBT"
 8" Cedar S72E 14.85' mrkd "S7 NBT"
 Bearings are magnetic. Distances are to nail with tag.

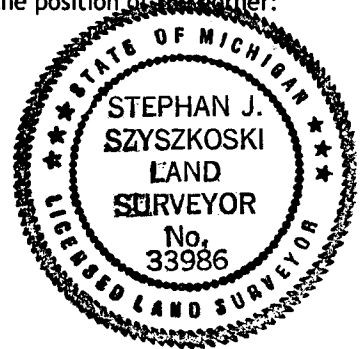

Signed by Stephan J. Szyszkoski
 Surveyor's Michigan License No. 33986

Date 1/31/06