

**LAND CORNER RECORDATION CERTIFICATE**  
**Filing Requirement of Act 74, Mich. P.A. 1970**

For corners in  
Chippewa  
 (County)

Located In:

Corner Code ##

- |                                    |                          |                         |
|------------------------------------|--------------------------|-------------------------|
| 1. Public Land Survey              | T <u>42N</u> R <u>2E</u> | <u>A6</u>               |
|                                    | T <u>42N</u> R <u>1E</u> | <u>M6 (same corner)</u> |
|                                    | T _____ R _____          | _____                   |
|                                    | T _____ R _____          | _____                   |
| 2. Property Controlling in Section | S _____ T _____ R _____  | _____                   |
|                                    | S _____ T _____ R _____  | _____                   |
| 3. Miscellaneous Property in Sec.  | S _____ T _____ R _____  | _____                   |
|                                    | S _____ T _____ R _____  | _____                   |


**Register of Deeds Stamp & File Number**

4. Lot No. \_\_\_\_\_, Recorded Plat \_\_\_\_\_  
 5. Private Claims \_\_\_\_\_

Jun 09 2005

I, Stephan J. Szyszkoski, in a field survey on \_\_\_\_\_, 19\_\_\_\_\_, do hereby certify that under requirements of P.A. 74, Michigan P.A. of 1970, the corner points mentioned in lines 1 and 2 above were in conformance with regulations and rules therefore as required in the current manual of survey instructions of the United States Department of the Interior, Bureau of Land Management or by a decree of a Court of Law and/or that the corner points mentioned in lines 3, 4 and 5 above were in conformance with the rules of the Michigan Board of Land Surveyors or by a Decree of a Court of Law; established, re-established, monumented, re-monumented, recovered, found as expressed below:

**NOTE: Not more than 4 corners, all in the same town and range, may be recorded on this certificate.**

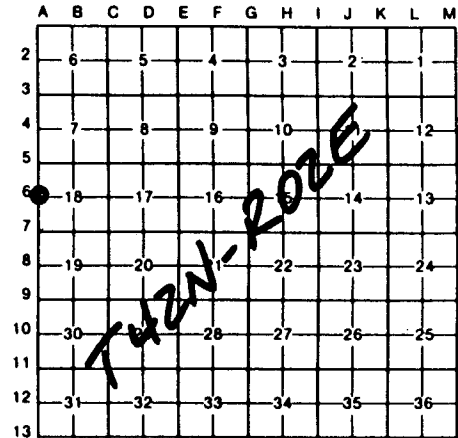

**A. Description of original monument and accessories and/or subsequent restoration:**

(A6) Quarter corner common to Section 18 T42N-R02E and Section 13 T42N-R01E. 1840 - Established by Austin Burt, Deputy Surveyor: South on East side of Section 13 ...40.00 Set Quarter Section post. Pine 22 N8W 24 links, Fir 6 S28W 12 links. ...80.00 Set post corner of Sections 13 & 24. 1973 - Billy Buckler states in LCRC of record: "Found 4" Concrete Plat Monument, set by G.F.DeLaMater, RLS in 1947. Found remains of original witness, a W.Pine stump N8W 24 links, as well as DeLaMaters witness, a W.Pine stump S21W 31.3'. Placed pile of stones on east side of corner monument. New bearing trees: 24" W.Pine stump S21W 32.4', 22" W.Pine stump S57E 24.4', 24" W.Pine stump N8W 16.0'."

**B. Description of corner evidence found and/or method applied in restoring or reestablishing corner:**

(A6) Found a 1/2" diameter rebar encased in a 4" dia. concrete cylinder in accord with the witnesses described in Mr. Buckler's record. Accepted same as careful and faithful perpetuation of the position of the original corner. Left the monument in place and marked new witnesses as described below.

**C. Description of monument for corner and accessories established to perpetuate locating the position of the corner:**

(A6) Fd. 1/2" rebar in 4" dia. concrete cylinder. Set measuring nails in:  
 7" Maple S49E 30.15' wrkd "1/4S NBT"  
 10" W.Pine S71E 77.7' do  
 6" Maple S56W 9.25' do  
 4" W.Birch N41E 34.05' do  
 Bearings are magnetic. Distances are to nail with tag.



Signed by Stephan J. Szyszkoski  
 Surveyor's Michigan License No. 33986  
 For the Michigan Department of Natural Resources

Date 1/10/06