LAND CORNER RECORDATION CERTIFICATE

Filing Requirement of Act 74, Mich. P.A. 1970

For corners in Chippewa (County)

	Located In:	Corner Code #
1. Public Land Survey	T 42N R 2E	B4
	T ____ R ____	
	T ____ R ____	
	T ____ R ____	
2. Property Controlling	S 7 T 42N R 2E	9
in Section	S ____ T ____ R ____	
3. Miscellaneous	S ____ T ____ R ____	
Property in Sec.	S ____ T ____ R ____	

Register of Deeds Stamp & File Number

4. Lot No. _____ , Recorded Plat _____
5. Private Claims _____

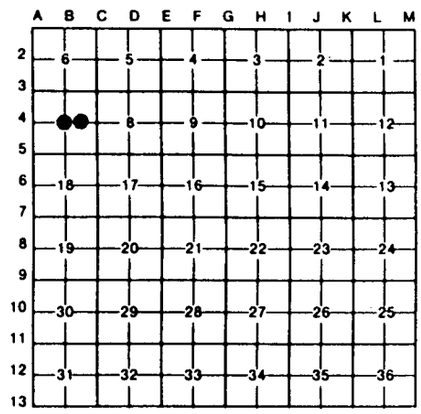

Sep 08 2005

I, Stephan J. Szyszkoski , in a field survey on _____ , 19 _____ , do hereby certify that under requirements of P.A. 74, Michigan P.A. of 1970, the corner points mentioned in lines 1 and 2 above were in conformance with regulations and rules therefore as required in the current manual of survey instructions of the United States Department of the Interior, Bureau of Land Management or by a decree of a Court of Law and/or that the corner points mentioned in lines 3, 4 and 5 above were in conformance with the rules of the Michigan Board of Land Surveyors or by a Decree of a Court of Law; established, re-established, monumented, re-monumented, recovered, found as expressed below:

NOTE: Not more than 4 corners, all in the same town and range, may be recorded on this certificate.

A. Description of original monument and accessories and/or subsequent restoration:

(B4) Center of Section 7. Not established in the original survey. Found no subsequent record.
(9-Sec. 7) East 1/16 corner, Section 7. Not established in the original survey. Found no subsequent record.

B. Description of corner evidence found and/or method applied in restoring or reestablishing corner:

(B4) Found no evidence of prior monumentation on the ground. Established the corner at the intersection of straight lines connecting opposite 1/4 corners.
(9-Sec. 7) Established the corner midway and on a straight line between Quarter corner 1344.10' east and Center of Section 1344.10' west.

C. Description of monument for corner and accessories established to perpetuate locating the position of the corner:

(B4) Set 1"IDx36" I.pipe with 4" alum. MDNR cap. Set measuring nails in:
6" Balsam S84E 7.92' mrkd "CS BT"
6" Balsam N75W 21.6' do
6" Balsam N19E 19.09' do
6" Balsam S58W 14.0' do
Bearings are magnetic. Distances are to nail with tag.

(9) Set chiseled "+" in 6'x6' limestone boulder. Set measuring nails in:
10" Balsam S80E 20.7' mrkd "E1/16 BT"
6" Maple S23E 12.58' do
12" Balsam S86W 37.2' do
10" Balsam N28E 32.65' do
drove a 5/8" capped rebar into a crack in the rock N09W 1.0' distant. Bearings are magnetic. Distances are to nail with tag.

STATE OF MICHIGAN
STEPHAN J. SZYSZKOSKI
LAND SURVEYOR
No. 33986
LICENSED LAND SURVEYOR

Signed by Stephan J. Szyszkoski Date 1/10/06

Surveyor's Michigan License No. 33986
For the Michigan Department of Natural Resources

FORM APPROVED BY MICHIGAN STATE BOARD OF LAND SURVEYORS, JAN. 28, 1971
REVISED MAY 14, 1975
REVISED JAN., 1983