LAND CORNER RECORDATION CERTIFICATE

Filing Requirement of Act 74, Mich. P.A. 1970

For corners in
Chippewa
(County)

	Located In:	Corner Code ##
1. Public Land Survey	T 42N R 2E	B5
	T ____ R ____	
	T ____ R ____	
	T ____ R ____	
2. Property Controlling	S ____ T ____ R ____	
in Section	S ____ T ____ R ____	
3. Miscellaneous	S ____ T ____ R ____	
Property in Sec.	S ____ T ____ R ____	

Register of Deeds Stamp & File Number

4. Lot No. _____ , Recorded Plat _____
5. Private Claims _____

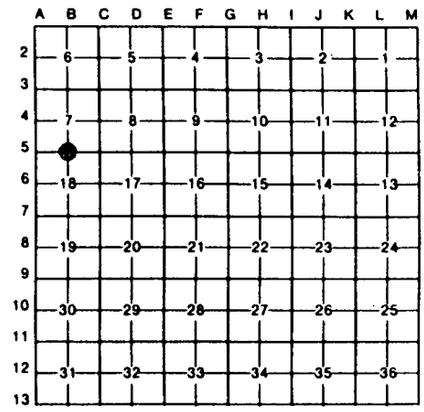

Sep 08 2005

I, Stephan J. Szyszkoski , in a field survey on _____ , 19 _____ , do hereby certify that under requirements of P.A. 74, Michigan P.A. of 1970, the corner points mentioned in lines 1 and 2 above were in conformance with regulations and rules therefore as required in the current manual of survey instructions of the United States Department of the Interior, Bureau of Land Management or by a decree of a Court of Law and/or that the corner points mentioned in lines 3, 4 and 5 above were in conformance with the rules of the Michigan Board of Land Surveyors or by a Decree of a Court of Law; established, re-established, monumented, re-monumented, recovered, found as expressed below:

NOTE: Not more than 4 corners, all in the same town and range, may be recorded on this certificate.

A. Description of original monument and accessories and/or subsequent restoration:

(B5) Quarter corner common to Sections 7-18. 1845 - Established by John Mullett, Deputy Surveyor: East corrected between Sections 7 & 18 ...41.62 Set Quarter Sec. post. Fir 8 S45W 14 links, Cedar 8 N35E 25 links. ...81.62 Section corner. Found no subsequent record.

B. Description of corner evidence found and/or method applied in restoring or reestablishing corner:

(B5) The original post and accessories were not recovered. Found no acceptable evidence of the position of the original corner on the ground. Reestablished the corner by single proportionate measurement to the original record between monumented Section corners 2780.78' west and 2672.54' east.

C. Description of monument for corner and accessories established to perpetuate locating the position of the corner:

(B5) Set 1"IDx36" I.pipe with 4" alum.
MDNR cap. Set measuring nails in:
14" W.Birch S10W 12.3' mrkd "1/4S NBT"
6" Spruce S62E 16.84' do
8" Spruce S78W 4.68' do
8" Spruce N60W 22.45' do
Bearings are magnetic. Distances are to nail with tag.

STATE OF MICHIGAN
STEPHAN J. SZYSZKOSKI
LAND SURVEYOR
No. 33986
LICENSED LAND SURVEYOR

Signed by Stephan J. Szyszkoski Date 1/10/06

Surveyor's Michigan License No. 33986
For the Michigan Department of Natural Resources

FORM APPROVED BY MICHIGAN STATE BOARD OF LAND SURVEYORS, JAN. 28, 1971
REVISED MAY 14, 1975
REVISED JAN., 1983