

LAND CORNER RECORDATION CERTIFICATE
Filing Requirement of Act 74, Mich. P.A. 1970 as Amended

For corners in

<u>Chippewa</u> (County)	Located In:	Corner Code #
1. Public Land Survey	T <u>42N</u> R <u>2E</u>	<u>C4</u>
	T _____ R _____	_____
	T _____ R _____	_____
2. Property Controlling in Section	S _____ T _____ R _____	_____
	S _____ T _____ R _____	_____
3. Miscellaneous Property in Sec.	S _____ T _____ R _____	_____
	S _____ T _____ R _____	_____
4. Lot No. _____, Recorded Plat _____		
5. Private Claims		

Register of Deeds Stamp & File Number

1	A	B	C	D	E	F	G	H	I	J	K	L	M
2		6		5		4		3		2		1	
3													
4		7		8		9		10		11		12	
5													
6		18		17		16		15		14		13	
7													
8		19		20		21		22		23		24	
9													
10		30		29		28		27		26		25	
11													
12		31		32		33		34		35		36	
13													

Oct 20 2005

I, Stephan J. Szyszkoski, in a field survey on _____, 20____ do hereby state that under requirements of P.A. 74, Michigan P.A. of 1970, the corner points mentioned in lines 1 and 2 above were in conformance with regulations and rules therefore as required in the current manual of survey instructions of the United States Department of the Interior, Bureau of Land Management or by a decree of a Court of Law and /or that the corner points mentioned in lines 3, 4 and 5 above were in conformance with the rules of the Michigan Board of Land Surveyors or by a Decree of a Court of Law; established, re-established, monumented, recovered, found as expressed below:

NOTE: Not more than 2 corners, all in the same town and range, may be recorded on this certificate.

A. Description of original monument and accessories and/or subsequent restoration:


(C4) Quarter corner common to Sections 7 and 8. 1845 - Established by John Mullett, Deputy Surveyor: North between Sections 7 & 8 ...40.00 Set Qr. Section post. Sugar 12 N55E 6 links, Fir 10 S40W 17 links. ...80.00 Section corner. 1977 - Reestablished by Gerald Gabel PS 10325 midway and on line between Section corners (rec. in LCRC L1 P244). Mr. Gabel set a 3"x4" brass cap on a 1.25" hex drill rod at the corner position and made witnesses: 5" Aspen S72-50'E 13.5', 3" Aspen N83-29'W 21.0', 12" Aspen S07-24'W 27.7'. 1991 - Corner remonumented by K.R.Waters PS 33142 at the 1977 position (rec. in LCRC L7 P343). Mr. Waters set a 1/2" rebar with plastic cap #33142 and made witnesses: 6" Aspen S16E 10.75', 4" Aspen N45E 20.04', 3" Aspen N40W 13.24', 6" W.Birch S34W 38.93'.

B. Description of corner evidence found and/or method applied in restoring or reestablishing corner:

(C4) Found and accepted the 1991 monument of record, in good condition and at record bearing and distance from the only remaining witness 8" (rec. as 6") W.Birch S34W 38.93', in good condition. Left the monument in place and made new witnesses as described below.

C. Description of monument for corner and accessories established to perpetuate locating the position of the corner:

(C4) Found 1/2" rebar with cap #33142.
 Set measuring nails in:
 9" W.Birch N50W 65.15' mrkd "1/4S NBT"
 8" W.Birch S40W 39.05' do *
 22" Maple N01E 84.3' do
 Power pole "FT2 94 24 D" N51E 30.35'
 Bearings are magnetic. Distances are to nail with MDNR tag. * denotes 1991 NBT.

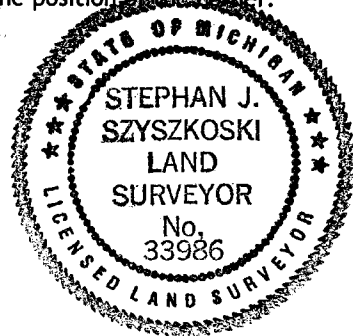

Signed by Stephan J. Szyszkoski
 Surveyor's Michigan License No. 33986

Date 3/12/07