LAND CORNER RECORDATION CERTIFICATE

Filing Requirement of Act 74, Mich. P.A. 1970

For corners in Chippewa (County)

	Located In:	Corner Code #
1. Public Land Survey	T 42N R 2E	C6
	T ___ R ___	
	T ___ R ___	
	T ___ R ___	
2. Property Controlling	S ___ T ___ R ___	
in Section	S ___ T ___ R ___	
3. Miscellaneous	S ___ T ___ R ___	
Property in Sec.	S ___ T ___ R ___	

Register of Deeds Stamp & File Number

4. Lot No. _____ , Recorded Plat _____
5. Private Claims _____

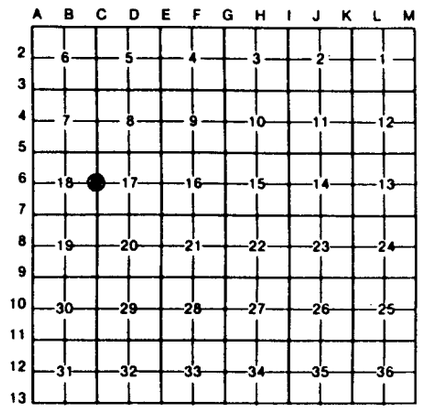

Sep 01 2005

I, Stephan J. Szyszkoski , in a field survey on _____ , 19 _____ , do hereby certify that under requirements of P.A. 74, Michigan P.A. of 1970, the corner points mentioned in lines 1 and 2 above were in conformance with regulations and rules therefore as required in the current manual of survey instructions of the United States Department of the Interior, Bureau of Land Management or by a decree of a Court of Law and/or that the corner points mentioned in lines 3, 4 and 5 above were in conformance with the rules of the Michigan Board of Land Surveyors or by a Decree of a Court of Law; established, re-established, monumented, re-monumented, recovered, found as expressed below:

NOTE: Not more than 4 corners, all in the same town and range, may be recorded on this certificate.

A. Description of original monument and accessories and/or subsequent restoration:

(C6) Quarter corner common to Sections 17 and 18. 1845: Established by John Mullett, Deputy Surveyor: North between Sections 17 & 18 ... 40.00 Set Quarter Section post. Fir 8 S45E 7 links, Spruce 10 N66W 18 links. ... 80.00 Set post corner of Secs. 7,8,17,18. Found no subsequent record.

B. Description of corner evidence found and/or method applied in restoring or reestablishing corner:

(C6) The original post and accessories were not recovered. Found no acceptable evidence of the position of the original corner on the ground. Reestablished the corner by single proportionate measurement to the original record, midway and on line between monumented Section corners C5 and C7.

C. Description of monument for corner and accessories established to perpetuate locating the position of the corner:

(C6) Set 1"x36" I.pipe with 4" alum.
MDNR cap, flush with ground surface.
Set measuring nails in:
5" Balsam S62E 53.25' mrkd "1/4S NBT"
4" W.Birch in clump S87W 27.45' do
5" W.Birch N40E 21.5' do
4" W.Birch N74E 53.95' do
Bearings are magnetic. Distances are to nail with tag.

STATE OF MICHIGAN
STEPHAN J. SZYSZKOSKI
LAND SURVEYOR
No. 33986
LICENSED LAND SURVEYOR

Signed by Stephan J. Szyszkoski Date 1/10/06

Surveyor's Michigan License No. 33986
For the Michigan Department of Natural Resources

FORM APPROVED BY MICHIGAN STATE BOARD OF LAND SURVEYORS, JAN. 28, 1971
REVISED MAY 14, 1975
REVISED JAN., 1983