

LAND CORNER RECORDATION CERTIFICATE
Filing Requirement of Act 74, Mich. P.A. 1970

For corners in
Chippewa
 (County)

Located In:

Corner Code ≠#

- | | | |
|------------------------------------|--------------------------|-----------|
| 1. Public Land Survey | T <u>42N</u> R <u>2E</u> | <u>C9</u> |
| | T _____ R _____ | _____ |
| | T _____ R _____ | _____ |
| | T _____ R _____ | _____ |
| 2. Property Controlling in Section | S _____ T _____ R _____ | _____ |
| | S _____ T _____ R _____ | _____ |
| 3. Miscellaneous Property in Sec. | S _____ T _____ R _____ | _____ |
| | S _____ T _____ R _____ | _____ |

Register of Deeds Stamp & File Number

4. Lot No. _____, Recorded Plat _____
 5. Private Claims _____

Aug 31 2005

I, Stephan J. Szyszkoski, in a field survey on _____, 19____, do hereby certify that under requirements of P.A. 74, Michigan P.A. of 1970, the corner points mentioned in lines 1 and 2 above were in conformance with regulations and rules therefore as required in the current manual of survey instructions of the United States Department of the Interior, Bureau of Land Management or by a decree of a Court of Law and/or that the corner points mentioned in lines 3, 4 and 5 above were in conformance with the rules of the Michigan Board of Land Surveyors or by a Decree of a Court of Law; established, re-established, monumented, re-monumented, recovered, found as expressed below:

NOTE: Not more than 4 corners, all in the same town and range, may be recorded on this certificate.

	A	B	C	D	E	F	G	H	I	J	K	L	M
2	6		5		4		3		2		1		
3													
4	7		8		9		10		11		12		
5													
6	18		17		16		15		14		13		
7													
8	19		20		21		22		23		24		
9													
10	30		29		28		27		26		25		
11													
12	31		32		33		34		35		36		
13													

A. Description of original monument and accessories and/or subsequent restoration:


(C9) Corner common to Sections 19-20-29-30. 1845 - Established by John Mullett, Deputy Surveyor. Bearing trees were: Aspen 12 N43W 9 links, Spruce 6 S1E 7 links. 1979 - Reestablished by proportionate measurement by Billy D. Buckler, RLS, between corners 1 mile to north, south, and west, and 3 miles east. Placed 1" pipe with 4" MDNR cap at the corner. Witnesses: 13" Cedar N9E 16.0', 13" Cedar S37E 58.3', 14" S.Maple East 50.0'.

B. Description of corner evidence found and/or method applied in restoring or reestablishing corner:

(C9) Found and accepted the 1979 monument of record, in good condition and at record bearing and distance from the 1979 witnesses. The Cedar NE is dead and down. The Cedar SE and the Maple East, are in good condition. I used the position of this monument to reestablish corner 89 and to partially subdivide Section 19.

C. Description of monument for corner and accessories established to perpetuate locating the corner:

(C9) Found 1" ID I. pipe with 4" alum. MDNR cap. Set measuring nails in:
 18" Maple S20W 16.25' wrkd "S30 NBT" *
 14" Maple S89E 50.35' "S29 NBT" *
 9" Maple S71W 3.6' "S30 NBT" *
 16" Cedar S35E 59.0' "S29" *
 Bearings are magnetic. Distances are to nail with MDNR tag. * denotes that I found but did not measure to nail and tag in tree previously placed by R. Bischer, PS.

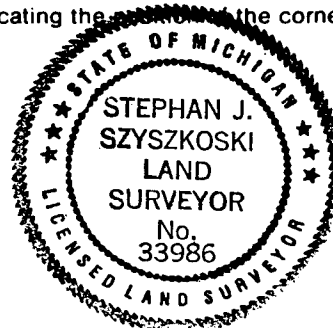

Signed by Stephan J. Szyszkoski
 Surveyor's Michigan License No. 33986
 For the Michigan Department of Natural Resources

Date 1/10/06