LAND CORNER RECORDATION CERTIFICATE

Filing Requirement of Act 74, Mich. P.A. 1970

For corners in Chippewa (County)

	Located In:	Corner Code #
1. Public Land Survey	T ____ R ____	
	T ____ R ____	
	T ____ R ____	
	T ____ R ____	
2. Property Controlling	S 19 T 42N R 2E	3
in Section	S ____ T ____ R ____	
3. Miscellaneous	S ____ T ____ R ____	
Property in Sec.	S ____ T ____ R ____	

Register of Deeds Stamp & File Number

4. Lot No. _____ , Recorded Plat _____
5. Private Claims _____

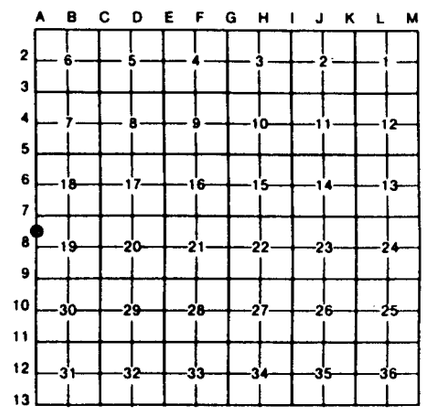

Jul 05 2005

I, Stephan J. Szyszkoski , in a field survey on _____ , 19 _____ , do hereby certify that under requirements of P.A. 74, Michigan P.A. of 1970, the corner points mentioned in lines 1 and 2 above were in conformance with regulations and rules therefore as required in the current manual of survey instructions of the United States Department of the Interior, Bureau of Land Management or by a decree of a Court of Law and/or that the corner points mentioned in lines 3, 4 and 5 above were in conformance with the rules of the Michigan Board of Land Surveyors or by a Decree of a Court of Law; established, re-established, monumented, re-monumented, recovered, found as expressed below:

NOTE: Not more than 4 corners, all in the same town and range, may be recorded on this certificate.

A. Description of original monument and accessories and/or subsequent restoration:

(3-Sec. 19) North 1/16 corner between Section 19 T42N-R02E and Section 24 T42N-R01E. Not established in the original survey. Described as being monumented with a 1/2" rod and cap on a survey drawing by Ronald Bischer RLS, dated April, 2000. The position for the corner is midway and on line between Section corner 1334.51' north and Quarter corner 1334.51' south. No witness trees given.

B. Description of corner evidence found and/or method applied in restoring or reestablishing corner:

(3-Sec. 19) Recovered and accepted the 1/2" capped rebar placed by Mr. Bischer, found to have been properly established.

C. Description of monument for corner and accessories established to perpetuate locating the position of the corner:

(3) Found 1/2" rebar with plastic cap
#22428. Set meausuring nails in:
5" Balsam N11W 20.55' mrkd "N1/16 BT"
9" Balsam South 19.75' do
6" Balsam N81W 22.3' do
6" W.Birch S67E 26.5' do
Bearings are magnetic. Distances are to nail with tag.

STATE OF MICHIGAN
STEPHAN J. SZYSZKOSKI
LAND SURVEYOR
No. 33986
LICENSED LAND SURVEYOR

Signed by Stephan J. Szyszkoski Date 1/10/06

Surveyor's Michigan License No. 33986
For the Michigan Department of Natural Resources

FORM APPROVED BY MICHIGAN STATE BOARD OF LAND SURVEYORS, JAN. 28, 1971
REVISED MAY 14, 1975
REVISED JAN., 1983