

LAND CORNER RECORDATION CERTIFICATE
Filing Requirement of Act 74, Mich. P.A. 1970

For corners in
Chippewa
 (County)

Located In: _____ Corner Code # _____

1. Public Land Survey	T _____ R _____	_____
	T _____ R _____	_____
	T _____ R _____	_____
	T _____ R _____	_____
2. Property Controlling in Section	S <u>7</u> T <u>42N</u> R <u>2E</u>	<u>5</u>
	S <u>7</u> T <u>42N</u> R <u>2E</u>	<u>1</u>
3. Miscellaneous Property in Sec.	S _____ T _____ R _____	_____
	S _____ T _____ R _____	_____

Register of Deeds Stamp & File Number

4. Lot No. _____, Recorded Plat _____
 5. Private Claims _____

1 Oct 10 2005
 5 Sep 12 2005

I, Stephan J. Szyszkoski, in a field survey on _____, 19_____, do hereby certify that under requirements of P.A. 74, Michigan P.A. of 1970, the corner points mentioned in lines 1 and 2 above were in conformance with regulations and rules therefore as required in the current manual of survey instructions of the United States Department of the Interior, Bureau of Land Management or by a decree of a Court of Law and/or that the corner points mentioned in lines 3, 4 and 5 above were in conformance with the rules of the Michigan Board of Land Surveyors or by a Decree of a Court of Law; established, re-established, monumented, re-monumented, recovered, found as expressed below:

NOTE: Not more than 4 corners, all in the same town and range, may be recorded on this certificate.

A. Description of original monument and accessories and/or subsequent restoration:


(5-Sec. 7) North 1/16 corner, Section 7. Not established in the original survey. Found no subsequent record.
 (1-Sec. 7) West 1/16 corner between Sections 6 and 7. Not established in the original survey.

B. Description of corner evidence found and/or method applied in restoring or reestablishing corner:

(5-Sec. 7) Established the corner midway and on a straight line between Quarter corner 1331.30' north and Center of Section 1331.30' south.
 (1-Sec. 7) Established the corner at 20 chains, proportionate to the original record, west of Quarter corner B3 and on the Section line between B3 1351.55' east and Section corner A3 1458.32' west.

C. Description of monument for corner and accessories established to perpetuate locating the position of the corner:

(5) Set 1"IDx36" I.pipe with 4" alum. MDNR cap. Set measuring nails in: 5" Balsam S19E 9.1' mrkd "N1/16 BT" triple 10" Maple N30W 8.4' do 14" Cedar S10W 19.83' do 5" Balsam N27E 32.0' do	(1) Set 1"IDx36" I.pipe with 4" alum. MDNR cap. Set measuring nails in: 7" Cedar S15W 0.95' mrkd "W1/16 BT" 12" Cedar N45E 19.15' do 6" Cedar S67E 11.7' do 12" Tamarack S76W 23.6' do
Bearings are magnetic. Distances are to nail with tag.	Bearings are magnetic. Distances are to nail with tag.

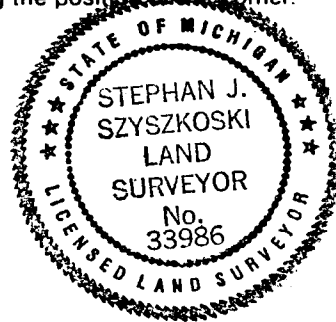

Signed by Stephan J. Szyszkoski Date 1/10/06

Surveyor's Michigan License No. 33986
 For the Michigan Department of Natural Resources

