

SURVEY & REMONUMENTATION

Chippewa County Remonumentation Corner

RECEIVED FOR RECORD
CHIPPEWA COUNTY
STATE OF MICHIGAN

MAR 09 1994

LAND CORNER RECORDATION CERTIFICATE
Filing Requirement of Act 74, Mich. P.A. 1970

93 DEC 29 PM 2:54

For corners in
Chippewa COMMISSION
(County)


Located In: Corner Code #

J. Roger Malott
REGISTER OF DEEDS

- | | | |
|------------------------------------|--------------------------|------------|
| 1. Public Land Survey | T <u>42N</u> R <u>3E</u> | <u>C-1</u> |
| | T _____ R _____ | _____ |
| | T _____ R _____ | _____ |
| | T _____ R _____ | _____ |
| 2. Property Controlling in Section | S _____ T _____ R _____ | _____ |
| | S _____ T _____ R _____ | _____ |
| 3. Miscellaneous Property in Sec. | S _____ T _____ R _____ | _____ |
| | S _____ T _____ R _____ | _____ |

Register of Deeds Stamp & File Number

4. Lot No. _____, Recorded Plat _____
5. Private Claims _____

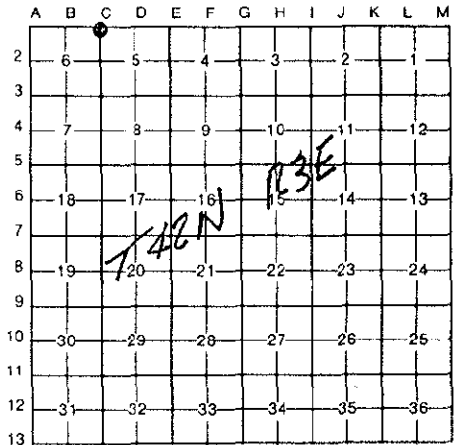

I, William L. Karr, in a field survey on December 14, 19 93, do hereby certify that under requirements of P.A. 74, Michigan P.A. of 1970, the corner points mentioned in lines 1 and 2 above were in conformance with regulations and rules therefore as required in the current manual of survey instructions of the United States Department of the Interior, Bureau of Land Management or by a decree of a Court of Law and/or that the corner points mentioned in lines 3, 4 and 5 above were in conformance with the rules of the Michigan Board of Land Surveyors or by a Decree of a Court of Law; established, re-established, monumented, re-monumented, recovered, found as expressed below:

NOTE: Not more than 4 corners, all in the same town and range, may be recorded on this certificate.

A. Description of original monument and accessories and/or subsequent restoration:

(C-1) Closing Corner for Sections 5 & 6 (T42N-R3E)

1981: William L. Karr, L.S. 27450. Corner recorded in Liber 5, Page 152 of the Chippewa County Corner Records. Found a concrete monument called for in Highway Department Records.

Nail in Power Pole	N55°E	38.87'	Stop Sign	S82°W	50.30'
Power Pole with Tag	N45°W	47.42'	Standard Corner	West	41.58'


1993: Chippewa County Road Commission. Added witnesses prior to road reconstruction.

Hub with Tack	East	23.82'
Triple Cedar	Southwest	97.62'

B. Description of corner evidence found and/or method applied in restoring or reestablishing corner:

(C-1) This corner is being perpetuated as part of the Chippewa County Remonumentation Program.

This corner was obliterated in road reconstruction. Found two record witness objects and the two Road commission witness objects. Used these to replace corner. Also found a nail with L.S. 22428 tag in a power pole to the Northwest. Since the nail and 22428 tag were lower and in better condition, the older nail was pulled after the corner was replaced and a new distance was taken. Added one additional witness.

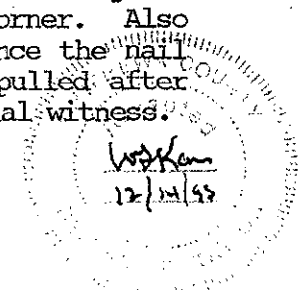

C. Description of monument for corner and accessories established to perpetuate locating the position of the corner:

(C-1) Corner is a 3/4" x 24" iron with plastic "Chippewa County Remonumentation" cap. Corner falls 3' East of the centerline of Gogomain Road (North-South, paved) and 1' South of the centerline of a paved road to the West.

Witnesses:

Power Pole (GT1/111)	N42°E	38.88'	(existing nail & L.S. 27450 tag)
5" Spruce	S58°E	32.73'	
Triple Cedar	S22°W	97.57'	(existing PK nail)
Power Pole	N47°W	46.97'	(existing nail & L.S. 22428 tag)
Standard Corner Sections 31 & 32	West	41.58'	



Signed by William L. Karr Date 12/23/93

Surveyor's Michigan License No. 27450

NOTE: Bearings are compass bearings corrected for declination.
Distances are to a nail in side of witness objects unless noted.