

JAN 18 2001

Chippewa County Remonumentation Corner

RECEIVED FOR RECORD  
CHIPPEWA COUNTY  
STATE OF MICHIGAN

93 DEC 29 PM 2:49

SECTION

LAND CORNER RECORDATION CERTIFICATE

Filing Requirement of Act 74, Mich. P.A. 1970

For corners in  
Chippewa

(County)

Located In:


Corner Code #

- 1. Public Land Survey T 43N R 2E D-1
- T \_\_\_\_\_ R \_\_\_\_\_
- T \_\_\_\_\_ R \_\_\_\_\_
- T \_\_\_\_\_ R \_\_\_\_\_
- 2. Property Controlling S \_\_\_\_\_ T \_\_\_\_\_ R \_\_\_\_\_
- in Section S \_\_\_\_\_ T \_\_\_\_\_ R \_\_\_\_\_
- 3. Miscellaneous S \_\_\_\_\_ T \_\_\_\_\_ R \_\_\_\_\_
- Property in Sec. S \_\_\_\_\_ T \_\_\_\_\_ R \_\_\_\_\_

*J. Roger Malott*  
REGISTER OF DEEDS

Register of Deeds Stamp & File Number

- 4. Lot No. \_\_\_\_\_, Recorded Plat \_\_\_\_\_
- 5. Private Claims \_\_\_\_\_

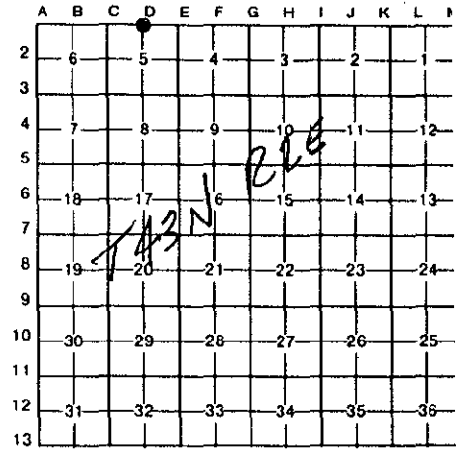

I, William L. Karr, in a field survey on December 7, 19 93, do hereby certify that under requirements of P.A. 74, Michigan P.A. of 1970, the corner points mentioned in lines 1 and 2 above were in conformance with regulations and rules therefore as required in the current manual of survey instructions of the United States Department of the Interior, Bureau of Land Management or by a decree of a Court of Law and/or that the corner points mentioned in lines 3, 4 and 5 above were in conformance with the rules of the Michigan Board of Land Surveyors or by a Decree of a Court of Law; established, re-established, monumented, re-monumented, recovered, found as expressed below:

**NOTE: Not more than 4 corners, all in the same town and range, may be recorded on this certificate.**

A. Description of original monument and accessories and/or subsequent restoration:

(D-7) North 1/4 Corner of Section 5, (T43N-R2E)

Corner was not established in original survey.

1963: Neal Sperhake, L.S. 7876 (Kimberly Clark Corp.). Witness Corner recorded in Liber 3, Page 120 of the Chippewa County Corner Records.

Re-established corner position midway between the Northwest and Northeast corners of Section 5 and held centerline of Gogomain Road for North-South position. Corner fell 19.80' West of the South 1/4 Corner of Section 32. Set a 1" pipe with stamped aluminum cap as a Witness Corner 33' South. Witnessed the Witness Corner.

B. Description of corner evidence found and/or method applied in restoring or reestablishing corner:

(D-7) This corner is being perpetuated as part of the Chippewa County Remonumentation Program.

Found a Pk nail 19.81' West of the South 1/4 Corner of Section 32. Distance East to the Northeast corner of Section 5 is 2676.25' (Sperhake - 2674.98'). Distance West to the Northwest corner of Section 5 is 2673.31' (Sperhake - 2674.98'). Accepted corner position as found and offset it prior to road reconstruction. Replaced corner after construction completed. Did not find witness corner set by Sperhake.

Note : Corner falls on the Township Line.

C. Description of monument for corner and accessories established to perpetuate locating the position of the corner:

(D-7) Corner is a 3/4" x 24" iron with plastic "Chippewa County Remonumentation" cap. Corner falls in centerline of Gogomain Road (East-West, paved). Falls 118' West of centerline of East Bay Road to the North (North-South, gravel).

Witnesses:

- 10" Balsam Poplar S08°E 59.89' (Common Witness)
- 1/2" Iron L.S. 27450 cap South 33.00'
- 10" Balsam Fir S48°W 94.92'
- 16" Aspen N54°W 71.22'
- South 1/4 Corner Section 32 East 19.81'



Signed by William L. Karr Date 12/29/93  
Surveyor's Michigan License No. 27450

NOTE: Bearings are compass bearings corrected for declination.

Distances are to a nail in side of witness objects unless noted.