

JAN 18 2001

Chippewa County Remonumentation Corner

RECEIVED FOR RECORD  
CHIPPEWA COUNTY  
STATE OF MICHIGAN

SECTION

LAND CORNER RECORDATION CERTIFICATE

93 DEC 29 PH 2:51

Filing Requirement of Act 74, Mich. P.A. 1970

For corners in  
Chippewa

(County)

Located In:

Corner Code #

- 1. Public Land Survey T 43N R 2E K-1  
T \_\_\_\_\_ R \_\_\_\_\_  
T \_\_\_\_\_ R \_\_\_\_\_  
T \_\_\_\_\_ R \_\_\_\_\_
- 2. Property Controlling S \_\_\_\_\_ T \_\_\_\_\_ R \_\_\_\_\_  
in Section S \_\_\_\_\_ T \_\_\_\_\_ R \_\_\_\_\_
- 3. Miscellaneous S \_\_\_\_\_ T \_\_\_\_\_ R \_\_\_\_\_  
Property in Sec. S \_\_\_\_\_ T \_\_\_\_\_ R \_\_\_\_\_

*J. Roger Malott*  
REGISTER OF DEEDS

Register of Deeds Stamp & File Number

- 4. Lot No. \_\_\_\_\_, Recorded Plat \_\_\_\_\_
- 5. Private Claims \_\_\_\_\_

A	B	C	D	E	F	G	H	I	J	K	L
2	6	5	4	3	2	1					
3											
4	7	8	9	10	11	12					
5											
6	18	17	16	15	14	13					
7											
8	19	20	21	22	23	24					
9											
10	30	29	28	27	26	25					
11											
12	31	32	33	34	35	36					
13											

I, William L. Karr, in a field survey on December 15, 19 93, do hereby certify that under requirements of P.A. 74, Michigan P.A. of 1970, the corner points mentioned in lines 1 and 2 above were in conformance with regulations and rules therefore as required in the current manual of survey instructions of the United States Department of the Interior, Bureau of Land Management or by a decree of a Court of Law and/or that the corner points mentioned in lines 3, 4 and 5 above were in conformance with the rules of the Michigan Board of Land Surveyors or by a Decree of a Court of Law; established, re-established, monumented, re-monumented, recovered, found as expressed below:

**NOTE: Not more than 4 corners, all in the same town and range, may be recorded on this certificate.**

A. Description of original monument and accessories and/or subsequent restoration:  
(K-1) Closing Corner 2/1 (T43N-R2E)


This corner was recovered by Neal Sperhake, L.S. 7876, on August 8, 1963 and recorded in the Chippewa County Corner Records in Liber 3, Page 106 in 1977. Sperhake found an iron bar and scribed wood post. The wood post is believed to have been set by the County Surveyor in an 1895 survey of the Township Line. Sperhake set a 1" x 36" galvanized pipe with Kimberly-Clark Corp. aluminum cap.

Witnesses: Tamarack 7 S43°W 32½ links  
Cedar 4 S19°E 28 links

B. Description of corner evidence found and/or method applied in restoring or reestablishing corner:  
(K-1) This corner is being perpetuated as part of the Chippewa County Remonumentation Program.

Found pipe with Kimberly-Clark Corp. aluminum cap as described in Liber 3, Page 106. Accepted corner position as found and added new witnesses.


Note: Corner falls 0.60' North of Township Line.

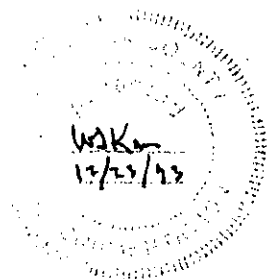

C. Description of monument for corner and accessories established to perpetuate locating the position of the corner:  
(K-1) Corner is a 1" galvanized pipe with a Kimberly-Clark Corp. aluminum cap. Corner falls on an East-West brush line.

Witnesses:

8" Cedar N23°E 11.37'  
14" Cedar N47°E 9.16'  
6" Cedar S11°E 18.83'  
10" Balsam S44°W 21.34'  
Standard Corner 35/36 East 31.91'

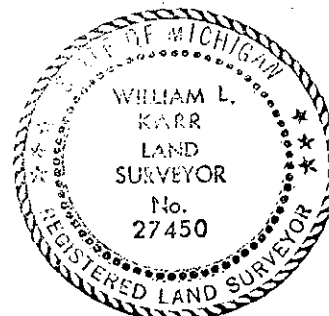

Signed by William L. Karr Date 12/23/93

Surveyor's Michigan License No. 27450

FORM APPROVED BY MICHIGAN STATE BOARD OF LAND SURVEYORS, JAN. 28, 19  
REVISED MAY 14, 19  
REVISED JAN. 19

NOTE: Bearings are compass bearings corrected for declination.  
Distances are to a nail in side of witness objects unless noted.