LAND CORNER RECORDATION CERTIFICATE

Filing Requirement of Act 74, Mich. P.A. 1970

For corners in Chippewa (County)

		Located In:		Corner Code #1
1. Public Land Survey		T 43N	R 2E	E9
		T	R	
		T	R	
		T	R	
2. Property Controlling	S	T	R	
in Section	S	T	R	
3. Miscellaneous	S	T	R	
Property in Sec	S	T	R	

Register of Deeds Stamp & File Number

4. Lot No. , Recorded Plat

5. Private Claims

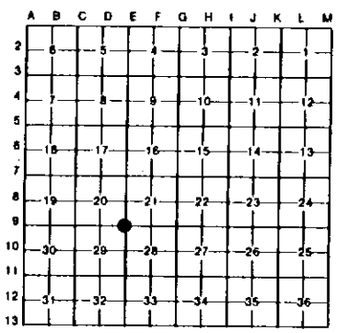

I, Stephan J. Szyszkoski, in a field survey on January 27, 1992, 19 , do hereby certify that under requirements of P.A. 74, Michigan P.A. of 1970, the corner points mentioned in lines 1 and 2 above were in conformance with regulations and rules therefore as required in the current manual of survey instructions of the United States Department of the Interior, Bureau of Land Management or by a decree of a Court of Law and/or that the corner points mentioned in lines 3, 4 and 5 above were in conformance with the rules of the Michigan Board of Land Surveyors or by a Decree of a Court of Law, established, re-established, monumented, re-monumented, recovered, found as expressed below:

NOTE: Not more than 4 corners, all in the same town and range, may be recorded on this certificate.

A. Description of original monument and accessories and/or subsequent restoration:

(E9) Corner previously recorded by B. D. Buckler (LCRC rec. L. 1, P. 185, Chippewa County records) as a chiseled cross on a large granite boulder with magnetic attraction.

B. Description of corner evidence found and/or method applied in restoring or reestablishing corner.

(E9) Found and accepted large granite boulder with 1/2" dia. rebar projecting from drilled hole. Did not find chiseled cross. Bucklers ties to fence corners NE and SW check.

C. Description of monument for corner and accessories established to perpetuate locating the position of the corner:

(E9) Found 1/2" rebar projecting from Granite Boulder below gravel road surface. N42E 37.5' Fence corner; S31W 34.1' Fence corner; N39W 47.8' Fd. WLK tag in W. face 22" H. Maple; S21W 26.7' Fd. WLK tag in 10" maple; N66E 54.25' Fd. WLK tag in 8" R. Pine. Bearings are magnetic (decl. 7 deg. W.)

STATE OF MICHIGAN
STEPHAN J. SZYSZKOSKI
LAND SURVEYOR
No. 33986
LICENSED LAND SURVEYOR

Signed by Stephan J. Szyszkoski Date 2-12-1992

Surveyor's Michigan License No. 33986

FORM APPROVED BY MICHIGAN STATE BOARD OF LAND SURVEYORS, JAN. 28, 1971
REVISED MAY 14, 1975
REVISED JAN., 1983