

SURVEY & REMONUMENTATION

Chippewa County Remonumentation Corner

RECEIVED FOR RECORD
CHIPPEWA COUNTY
STATE OF MICHIGAN

MAR 09 1994

LAND CORNER RECORDATION CERTIFICATE 89 DEC 29 PM 2:53
Filing Requirement of Act 74, Mich. P.A. 1970

For corners in
Chippewa
(County)


Located In: Corner Code #

J. Roger Malotte
REGISTER OF DEEDS

- | | | | | | |
|------------------------------------|---|------------|---|-----------|-------|
| 1. Public Land Survey | T | <u>43N</u> | R | <u>3E</u> | B-3 |
| | T | _____ | R | _____ | _____ |
| | T | _____ | R | _____ | _____ |
| | T | _____ | R | _____ | _____ |
| 2. Property Controlling in Section | S | _____ | T | _____ | R |
| | S | _____ | T | _____ | R |
| 3. Miscellaneous Property in Sec. | S | _____ | T | _____ | R |
| | S | _____ | T | _____ | R |

Register of Deeds Stamp & File Number

4. Lot No. _____, Recorded Plat _____
5. Private Claims _____

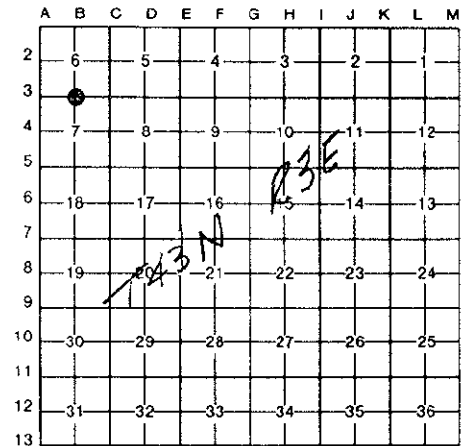

I, William L. Karr, in a field survey on December 14, 1993, do hereby certify that under requirements of P.A. 74, Michigan P.A. of 1970, the corner points mentioned in lines 1 and 2 above were in conformance with regulations and rules therefore as required in the current manual of survey instructions of the United States Department of the Interior, Bureau of Land Management or by a decree of a Court of Law and/or that the corner points mentioned in lines 3, 4 and 5 above were in conformance with the rules of the Michigan Board of Land Surveyors or by a Decree of a Court of Law; established, re-established, monumented, re-monumented, recovered, found as expressed below:


NOTE: Not more than 4 corners, all in the same town and range, may be recorded on this certificate.

A. Description of original monument and accessories and/or subsequent restoration:
(B-3) 1/2 Corner Common to Sections 6 & 7 (T43N-R3E)

1988: Larry R. Rogers, L.S. 29251. Corner recorded in Liber 7, Page 202 of the Chippewa County Corner Records.

Found 1/2" iron previously recorded in Liber 3, Page 188.

- | | | |
|---------------|-------|------------------------|
| 6" Maple | N08°E | 34.32' |
| 9" Cedar | S22°E | 79.63' |
| 15" Cedar | S18°W | 40.19' (existing ref.) |
| 8" Balsam Fir | N24°W | 46.24' |

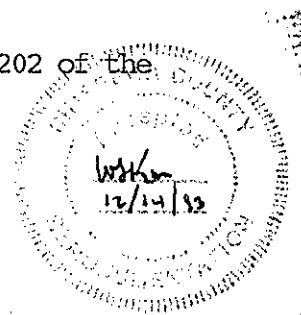

B. Description of corner evidence found and/or method applied in restoring or reestablishing corner:

(B-3) This corner is being perpetuated as part of the Chippewa County Remonumentation Program.

Found a 1/2" iron on extension of fence line to the South. Found the four bearing trees as recorded by Rogers. Each tree has a nail in the side. Accepted corner position as found and offset it prior to road reconstruction. Replaced corner after construction completed.

C. Description of monument for corner and accessories established to perpetuate locating the position of the corner:

(B-3) Corner is a 3/4" x 24" iron with plastic "Chippewa County Remonumentation" cap. Corner falls 0.5' North of the centerline Gogomain Road (East-West, paved). Falls on extension of fence line to the South.

Witnesses:

- | | | |
|---------------|-------|------------------------|
| 6" Maple | N08°E | 34.32' (existing nail) |
| 10" Cedar | S22°E | 79.63' (existing nail) |
| 18" Cedar | S18°W | 40.22' (existing nail) |
| 8" Balsam Fir | N24°W | 46.19' (existing nail) |



Signed by William L. Karr Date 12/23/93

Surveyor's Michigan License No. 27450

NOTE: Bearings are compass bearings corrected for declination.
Distances are to a nail in side of witness objects unless noted.