

MAR 09 1994

**Chippewa County Remonumentation Corner**

**LAND CORNER RECORDATION CERTIFICATE**  
**Filing Requirement of Act 74, Mich. P.A. 1970**

RECEIVED FOR RECORD  
 CHIPPEWA COUNTY  
 STATE OF MICHIGAN

93 DEC 29 PM 2: 53

For corners in  
Chippewa  
 (County)

COMMISSION


Located In: Corner Code #

1. Public Land Survey	T <u>43N</u> R <u>3E</u>	C-5
	T _____ R _____	_____
	T _____ R _____	_____
	T _____ R _____	_____
2. Property Controlling in Section	S _____ T _____ R _____	_____
	S _____ T _____ R _____	_____
3. Miscellaneous Property in Sec.	S _____ T _____ R _____	_____
	S _____ T _____ R _____	_____

*J. Roger Matlock*  
 REGISTER OF DEEDS

Register of Deeds Stamp & File Number

4. Lot No. \_\_\_\_\_, Recorded Plat \_\_\_\_\_  
 5. Private Claims \_\_\_\_\_

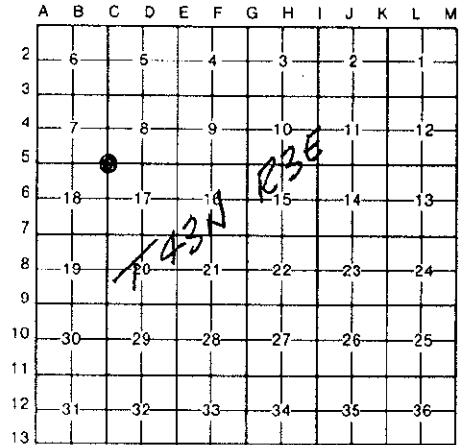

I, William L. Karr, in a field survey on December 14, 19 93, do hereby certify that under requirements of P.A. 74, Michigan P.A. of 1970, the corner points mentioned in lines 1 and 2 above were in conformance with regulations and rules therefore as required in the current manual of survey instructions of the United States Department of the Interior, Bureau of Land Management or by a decree of a Court of Law and/or that the corner points mentioned in lines 3, 4 and 5 above were in conformance with the rules of the Michigan Board of Land Surveyors or by a Decree of a Court of Law; established, re-established, monumented, re-monumented, recovered, found as expressed below:


**NOTE: Not more than 4 corners, all in the same town and range, may be recorded on this certificate.**

A. Description of original monument and accessories and/or subsequent restoration:  
(C-5) Section Corner Common to Sections 7, 8, 17 & 18 (T43N-R3E)

1982: William L. Karr, L.S. 27450. Corner recorded in Liber 6, Page 142 of the Chippewa County Corner Records.

Found  $\frac{1}{2}$ " iron, L.S. 5434, at intersecting centerlines.

Michigan Bell Box	N37°E	66.80'
Power Pole (GP1/195)	S40°E	49.94'
West End 15" C.M.P.	S41°W	40.00'
Corner Fence Post	N42°W	46.09'

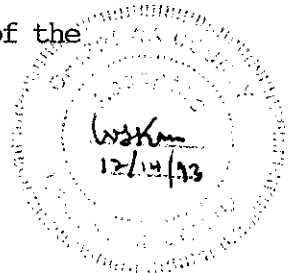

B. Description of corner evidence found and/or method applied in restoring or reestablishing corner:  
(C-5) This corner is being perpetuated as part of the Chippewa County Remonumentation Program.

Found a bent  $\frac{1}{2}$ " iron 8" below paved road surface. Found three record witness objects. Culvert has been replaced. Straightened iron. Accepted corner position as found and offset it prior to road reconstruction. Replaced corner after construction completed. Added two witnesses.

C. Description of monument for corner and accessories established to perpetuate locating the position of the corner:  
(C-5) Corner is a 3/4" x 24" iron with plastic "Chippewa County Remonumentation" cap. Corner falls 0.6' West of the centerline of Gogomain Road (North-South, paved) and on the centerline of East Clay Road and West Clay Road (East-West, gravel).

Witnesses:

Telephone Splice Box	N21°E	66.48' (box is shaky)
"V" Notch East End 16" C.M.P.	N37°E	41.33'
Power Pole (GP1/195)	S41°E	50.06' (existing PK)
"V" Notch West End 16" C.M.P.	S40°W	37.18' (new C.M.P.)
Corner Fence Post	N42°W	46.33' (existing PK - post leans)



Signed by William L. Karr Date 12/23/93

Surveyor's Michigan License No. 27450

NOTE: Bearings are compass bearings corrected for declination.  
 Distances are to a nail in side of witness objects unless noted.