

MAR 09 1994

Chippewa County Remonumentation Corner

RECEIVED FOR RECORD
CHIPPEWA COUNTY
STATE OF MICHIGAN

COMMISSION

LAND CORNER RECORDATION CERTIFICATE
Filing Requirement of Act 74, Mich. P.A. 1970

93 DEC 29 PM 2:54

For corners in

Chippewa

(County)

Located In:


Corner Code #

1. Public Land Survey	T <u>43N</u> R <u>3E</u>	<u>C-8</u>
	T _____ R _____	_____
	T _____ R _____	_____
	T _____ R _____	_____
2. Property Controlling in Section	S _____ T _____ R _____	_____
	S _____ T _____ R _____	_____
3. Miscellaneous Property in Sec.	S _____ T _____ R _____	_____
	S _____ T _____ R _____	_____

J. Roger Matlock
REGISTER OF DEEDS

Register of Deeds Stamp & File Number

4. Lot No. _____, Recorded Plat _____
5. Private Claims _____

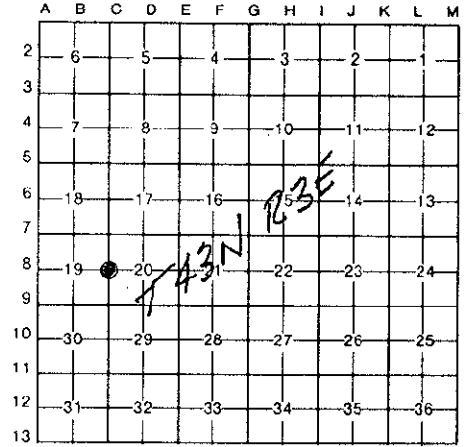

I, William L. Karr, in a field survey on December 14, 19 93, do hereby certify that under requirements of P.A. 74, Michigan P.A. of 1970, the corner points mentioned in lines 1 and 2 above were in conformance with regulations and rules therefore as required in the current manual of survey instructions of the United States Department of the Interior, Bureau of Land Management or by a decree of a Court of Law and/or that the corner points mentioned in lines 3, 4 and 5 above were in conformance with the rules of the Michigan Board of Land Surveyors or by a Decree of a Court of Law; established, re-established, monumented, re-monumented, recovered, found as expressed below:

NOTE: Not more than 4 corners, all in the same town and range, may be recorded on this certificate.

A. Description of original monument and accessories and/or subsequent restoration:

(C-8) $\frac{1}{2}$ Corner Common to Sections 19 & 20 (T43N-R3E)
1976: Ronald R. Bischer, L.S. 22428. Corner recorded in Liber 1, Page 238 of the Chippewa County Corner Records.
Found railroad spike.

8" Scotch Pine N52°W 44.98'
Power Pole N30°E 90.33'

1993: Chippewa County Road Commission - Prior to road reconstruction.
Fence Post Northeast 62.40'
Corner Fence Post Southeast 44.97'
15" Pine Northwest 45.32'

B. Description of corner evidence found and/or method applied in restoring or reestablishing corner:

(C-8) This corner is being perpetuated as part of the Chippewa County Remonumentation Program.


This corner was obliterated in road reconstruction work. Found the two witness objects as recorded by Bischer. The Pine is a Red Pine. Each object has a nail and L.S. 22428 tag in the side. The nail in the Pine was grown over, chopped out. Found the three Road Commission's witness objects. Each has a nail in the side. Road Commission nail in a different location on Pine. Replaced the corner from the ties. Placed a new nail and tag above the existing nail and tag in Pine. Pulled the Road Commission nail out of the Pine. Added an additional witness.

C. Description of monument for corner and accessories established to perpetuate locating the position of the corner:

(C-8) Corner is a 3/4" x 24" iron with plastic "Chippewa County Remonumentation" cap. Corner falls 2' East of the centerline of Gogomain Road (North-South, paved). Falls on the extension of a fence line to the West.

Witnesses:

Power Pole (GP1/170) N20°E 90.23' (existing nail & L.S. 22428 tag)
Fence Post N40°E 62.36' (existing nail)
Corner Fence Post S45°E 45.02' (existing nail)
"X" Chiseled in the East End of a 4' x 2' Boulder S87°W 110.36'
10" Red Pine N57°W 44.96' (existing - new nail & tag)

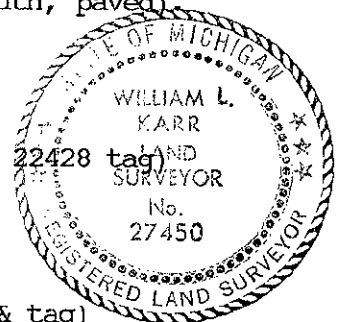

Signed by William L. Karr Date 12/13/93

Surveyor's Michigan License No. 27450

NOTE: Bearings are compass bearings corrected for declination.
Distances are to a nail in side of witness objects unless noted.