


L8
Pg 201
0

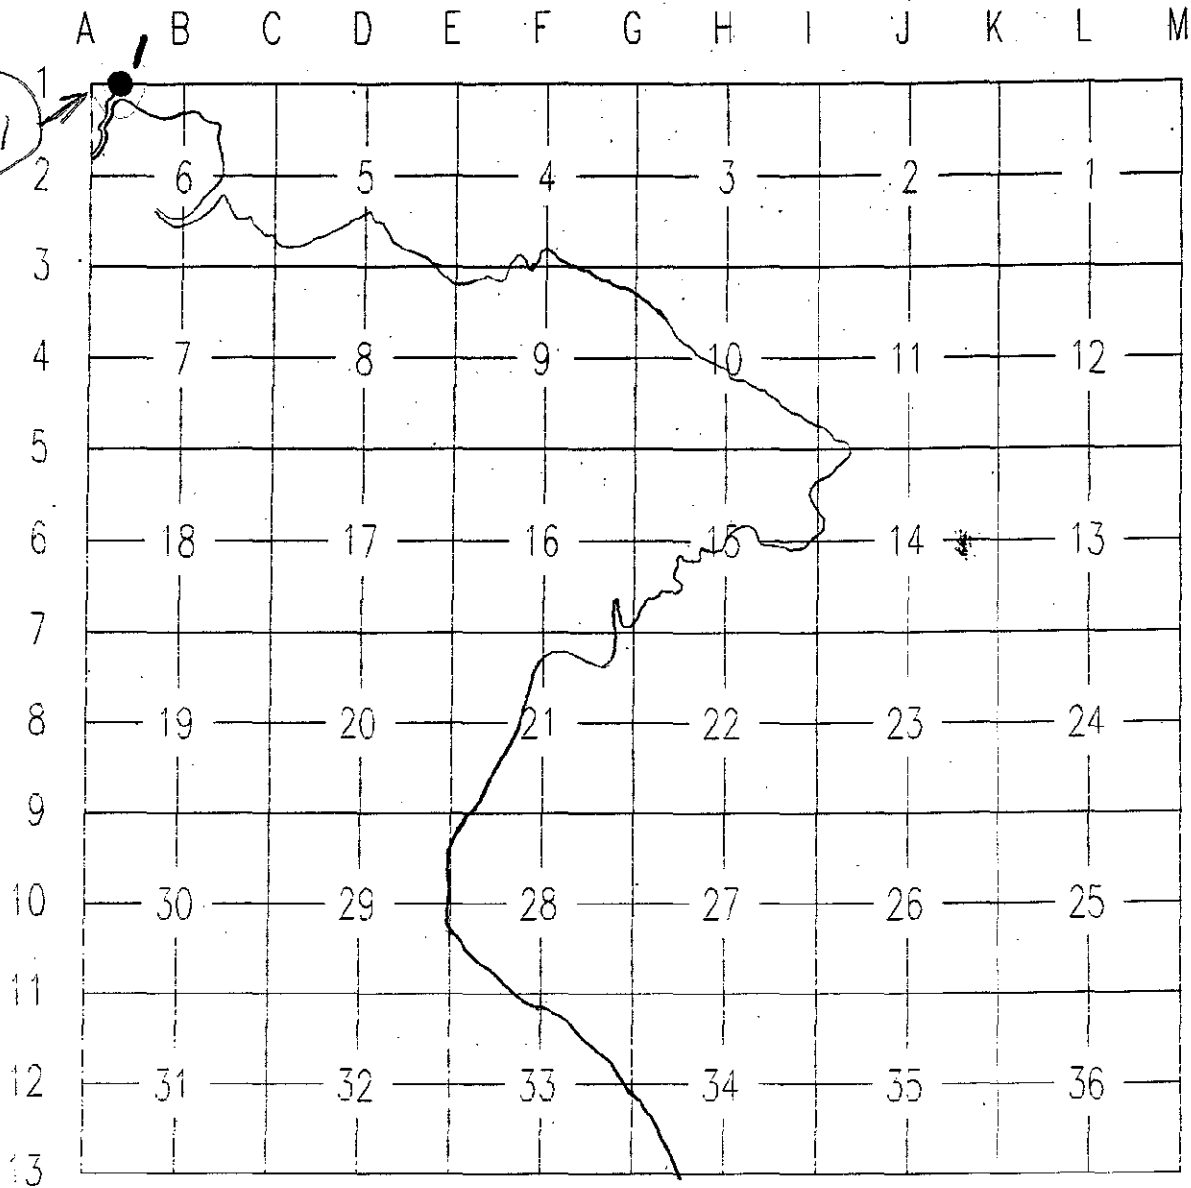

T43N-R3E

SURVEY &
REMONUMENTATION

JUL 22 1999

SECTION

Chippewa Co.