


CHIPPEWA COUNTY 17

Form 974.

T. 43 N. R. 6 E

Mer.

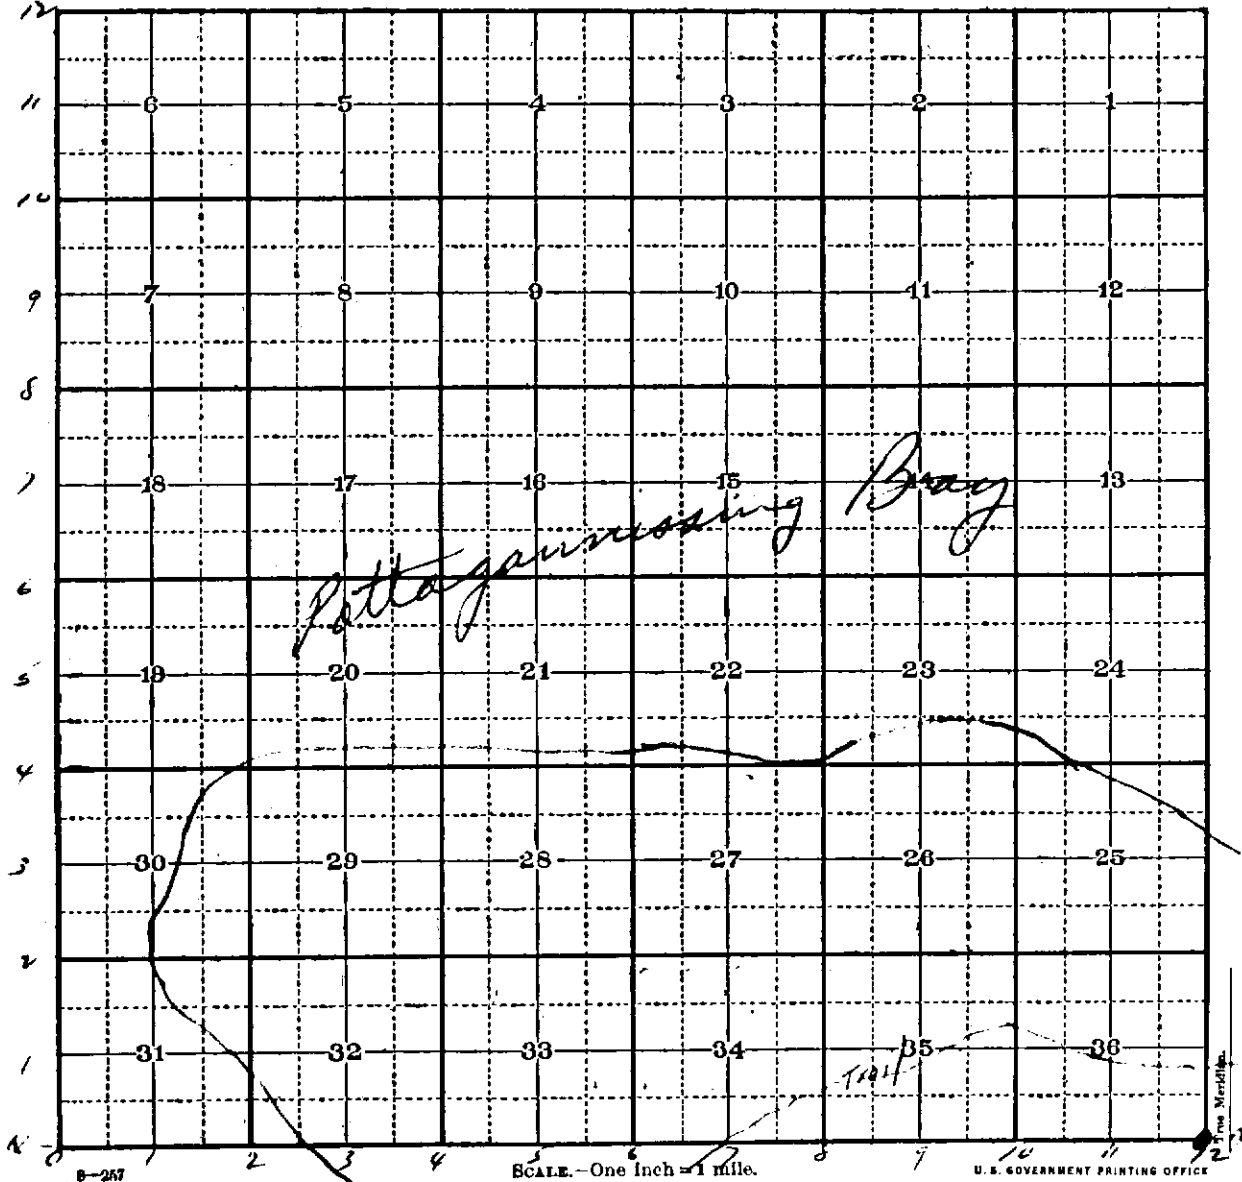

Drummond Island