

1993

COMMISSION

CHIPPEWA COUNTY REMONUMENTATION CORNER
LAND CORNER RECORDATION CERTIFICATE
Filing Requirement of Act 74, Mich. P.A. 1970

RECEIVED FOR RECORD
CHIPPEWA COUNTY
STATE OF MICHIGAN

93 DEC -3 PM 3: 58

For corners in
Chippewa
(County)

Located In: Corner Code #

1. Public Land Survey	T43N R 1E	A-7	Same
	T43N R 1W	M-7	Corner
	T ___ R ___		
	T ___ R ___		
2. Property Controlling in Section	S ___ T ___ R ___		
	S ___ T ___ R ___		
3. Miscellaneous Property in Sec.	S ___ T ___ R ___		
	-S ___ T ___ R ___		

J. Roger Madole
REGISTER OF DEEDS

Register of Deeds Stamp & File Number

- 4. Lot No. _____, Recorded Plat _____
- 5. Private Claims _____

I, Keith R. Waters in a field survey on June 3, 19 93, do hereby certify that under requirements of P.A. 74, Michigan P.A. of 1970, the corner points mentioned in lines 1 and 2 above were in conformance with regulations and rules therefore as required in the current manual of survey instructions of the United States Department of the Interior, Bureau of Land Management or by a decree of a Court of Law and/or that the corner points mentioned in lines 3, 4 and 5 above were in conformance with the rules of the Michigan Board of Land Surveyors or by a Decree of a Court of Law; established, re-established, monumented, re-monumented, recovered, found as expressed below:

NOTE: Not more than 4 corners, all in the same town and range, may be recorded on this certificate.

A. Description of original monument and accessories and/or subsequent restoration:

A-7 (T43N, R1E)
Section Corner Common to Sections 18 & 19, T43N, R1E and Sections 19 & 24, T43N, R1W.


Corner recorded by Neil E. Hill, P.S. 27447, in liber 7, page 356 of Chippewa County corner records (11-19-1991) as an iron rod in a monument box with the following ties: Power Pole, S75°E 67.83' Power Pole, West 73.33'
7" Elm, N65°W 54.75' 6" Ash, N45°W 63.95'

B. Description of corner evidence found and/or method applied in restoring or reestablishing corner:

A-7 (T43N, R1E)
This corner is being perpetuated as part of the Chippewa County Remonumentation Program.
Found a 1" iron pin in a monument box approximately 4.5 feet east of centerline of Highway M-129. Two power poles with M.D.O.T. tags as called for in 1991 records are intact. Distances from poles to corner match very closely with 1991 records. Two witness trees have been cut down. corner as found and established two new witness trees.

C. Description of monument for corner and accessories established to perpetuate locating the position of the corner:

A-7 (T43N, R1E)
Corner is a 1" iron pin in a monument box 4.5 feet east of centerline of Highway M-129. Witnesses:
Power Pole (200), S76°E 67.77' Note: Distances to poles are to a MDOT brass tag in the side. Distances to trees are to a nail and tag in side of tree.
Power Pole (E26), West 73.38' Trees are painted and blazed. Bearings are compass bearings corrected for declination.
6" Tamarack, N68°E 118.95'
7" White Birch, S55°W 119.34'

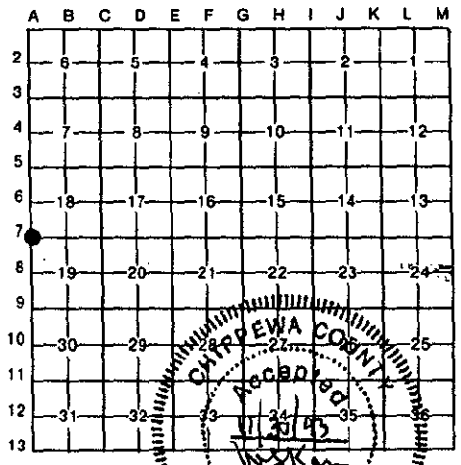

Signed by Keith R. Waters Date 11-30-93
Surveyor's Michigan License No. 33142