

MAY 28 1997

COMMISSION

CHIPPEWA COUNTY REMONUMENTATION CORNER

LAND CORNER RECORDATION CERTIFICATE
Filing Requirement of Act 74, Mich. P.A. 1970

For corners in

<u>Chippewa</u> (County)	Located In:	Corner Code #
1. Public Land Survey	T <u>43</u> N R <u>1E</u>	<u>C-8</u>
	T___ R___	_____
	T___ R___	_____
	T___ R___	_____
2. Property Controlling in Section	S___ T___ R___	_____
	S___ T___ R___	_____
3. Miscellaneous Property in Sec.	S___ T___ R___	_____
	S___ T___ R___	_____

\$2.00 NSSR
2/28/1997 2:42:19 PM
RECEIVED
CHIPPEWA COUNTY
SHARON H.
REGISTER OF DEEDS


BOOK 9 PAGE 347

Register of Deeds Stamp & File Number

4. Lot No. _____, Recorded Plat _____
5. Private Claims _____

I, William L. Karr, in a field survey on Dec. 6, 1996 do hereby state that under requirements of P.A. 74, Michigan P.A. of 1970, the corner points mentioned in lines 1 and 2 above were in conformance with regulations and rules therefore as required in the current manual of survey instructions of the United States Department of the Interior, Bureau of Land Management or by a decree of a Court of Law and/or that the corner points mentioned in lines 3, 4 and 5 above were in conformance with the rules of the Michigan Board of Land Surveyors or by a Decree of a Court of Law; established, re-established, monumented, recovered, found as expressed below:

NOTE: Not more than 2 corners, all in the same town and range, may be recorded on this certificate.

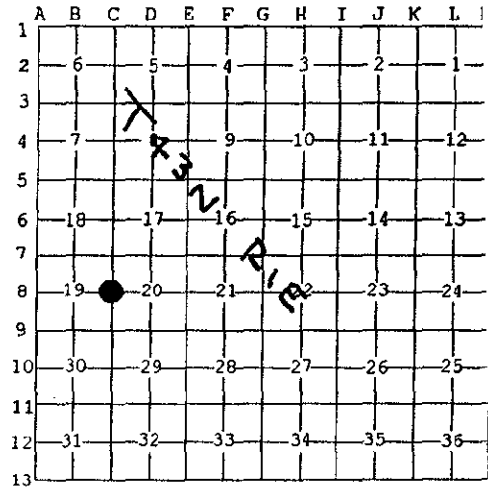

A. Description of original monument and accessories and/or subsequent restoration:

(C-8) 1/4 Corner Common to Sections 19 & 20, T.43 N., R.1 E.
1845: J.H. Mullet set quarter Section post Ironwood N35°W 6 Ironwood N80°E 13
1900: F.H. Brown County Surveyor surveyed Section 20 and notes the West line at 5241' and split evenly - there is no mention of finding the 1/4 corner.
1904: F.H. Brown County Surveyor surveyed the line between Sections 19 & 20. He starts at the Northeast of Section 19 (an original corner) and chains South 5391' to an original corner. The 1/4 corner was not in place. His notes indicate the North 1/2 mile as 2677' and the South 1/2 mile as 2695' and 2713 (notes conflict)

B. Description of corner evidence found and/or method applied in restoring or reestablishing corner:

(C-8) This Corner is being perpetuated as part of the Chippewa County Remonumentation Program.
 Found no evidence of original corner. Found a 1-1/2" galvanized pipe that [unclear] (Portice) said was in position when he bought his property in 1951. Distance North to Section corner is 2678.90 (C.S. was 2677'). Distance South to Section corner is 2715.78 (C.S. 2713'). Corner was accepted as found. Set a 3/4" x 24" rebar in the pipe and stamped the aluminum Chippewa County Remonumentation cap.

C. Description of monument for corner and accessories established to perpetuate locating the position of the corner:

(C-8) Corner is a 3/4" x 24" rebar with stamped aluminum Chippewa County Remonumentation cap set inside a 1-1/2" galvanized pipe:

Witnesses:	Sugar Maple 6"	N05°E	66.78'
	Sugar Maple 6"	S48°E	35.32'
	Sugar Maple 10"	S26°W	18.82'
	Sugar Maple 11"	N57°W	66.69'
	Sugar Maple 7"	N25°W	70.71'

Signed by William L. Karr
 Surveyor's Michigan License No. 27450

Date 12-30-96



NOTE: All bearings are compass bearings corrected for declination. All distances are to a nail in side of witness object, unless noted.