

SURVEY & REMONUMENTATION

MAY 28 1997

COMMISSION

CHIPPEWA COUNTY REMONUMENTATION CORNER

LAND CORNER RECORDATION CERTIFICATE
Filing Requirement of Act 74, Mich. P.A. 1970

For corners in

<u>Chippewa</u> (County)	Located In:	Corner Code #
1. Public Land Survey	T43N R 1E	C-9
	T ___ R ___	_____
	T ___ R ___	_____
	T ___ R ___	_____
2. Property Controlling in Section	S ___ T ___ R ___	_____
	S ___ T ___ R ___	_____
3. Miscellaneous Property in Sec.	S ___ T ___ R ___	_____
	S ___ T ___ R ___	_____

\$7.00 LAND CORNER

\$2.00 MSSR
2/28/1997 2:45:44 PM Receipt
RECEIVED FOR RECORD
CHIPPEWA COUNTY - STATE OF MICH
SHARON H. KENNEDY, REGISTER OF


BOOK 9 PAGE 348

Register of Deeds Stamp & File Number

4. Lot No. _____, Recorded Plat _____
5. Private Claims _____

I, William L. Karr, in a field survey on Dec. 6, 1996 do hereby state that under requirements of P.A. 74, Michigan P.A. of 1970, the corner points mentioned in lines 1 and 2 above were in conformance with regulations and rules therefore as required in the current manual of survey instructions of the United States Department of the Interior, Bureau of Land Management or by a decree of a Court of Law and/or that the corner points mentioned in lines 3, 4 and 5 above were in conformance with the rules of the Michigan Board of Land Surveyors or by a Decree of a Court of Law; established, re-established, monumented, recovered, found as expressed below:

NOTE: Not more than 2 corners, all in the same town and range, may be recorded on this certificate.

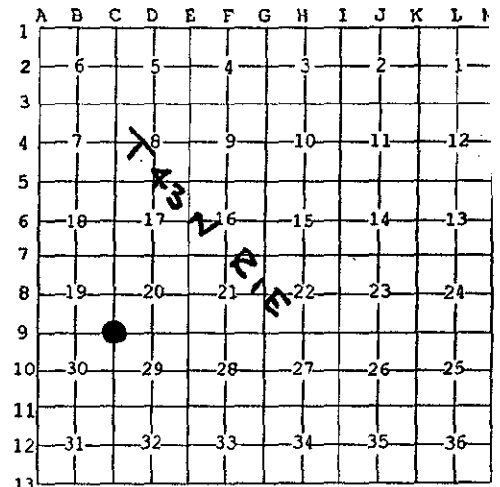

A. Description of original monument and accessories and/or subsequent restoration:

(C-9) Section Corner Common to Sections 19, 20, 29 & 30, T.43 N., R.1 E.
1845: J.H. Mullet set post Sugar 15 S71°E 8 Hemlock 7 N76°W 14
1904: F.H. Brown County Surveyor surveyed the East and South lines of Section 19. He notes an original corner at the Northeast and Southeast corners of Section 19.
19???: Undated field notes I believe to be Brown's, re-witnessed the Southeast corner of Section 19. Cedar N50°E 55' Cedar 6" S14°W 56' Pine N03°W 208'

B. Description of corner evidence found and/or method applied in restoring or reestablishing corner:

(C-9) This Corner is being re-established as part of the Chippewa County Remonumentation Program. Found no evidence of original corner. Found a concrete monument set by U.S. Steel Surveyors in the 1940's. Could find no history or theory for this position. I established a search area 5391' South of the N.E. corner of Section 19 & 5295' East of the S.W. corner of Section 19 (based on Brown's 1904 survey). I found (2) Cedar stumps (burned) which match Brown's undated notes. I re-constructed the corner from these stumps and set a 3/4" x 24" rebar and stamped the aluminum Chippewa County Remonumentation cap. This position is 5394.68' South of N.E. corner of Section 19 (C.S. 5391') & 5298.11' East of the S.W. corner of Section 19 (C.S. 5295'). In addition a G.L.O. call to a limestone ledge 5.00 chains to the South is consistent with this position. The U.S. Steel corner is 133'+ North & 39'+ West of the re-established corner.

C. Description of monument for corner and accessories established to perpetuate locating the position of the corner:

(C-9) Corner is a 3/4" x 24" rebar with stamped aluminum Chippewa County Remonumentation cap.

Witnesses:	W. Birch 10"	N54°E	13.85'
	Aspen 11"	S11°W	39.74'
	Aspen 12"	S45°W	10.38'
	W. Birch 8"	N20°W	14.12'



Signed by William L. Karr
Surveyor's Michigan License No. 27450

Date 12-30-96

NOTE: All bearings are compass bearings corrected for declination. All distances are to a nail in side of witness objects unless noted.