

SURVEY & REMONUMENTATION

MAR 09 1994

COMMISSION

Chippewa County Remonumentation Corner

RECEIVED FOR RECORD  
CHIPPEWA COUNTY  
STATE OF MICHIGAN

LAND CORNER RECORDATION CERTIFICATE  
Filing Requirement of Act 74, Mich. P.A. 1970

93 DEC 29 PM 2:48

For corners in  
Chippewa

(County)

Located In:

Corner Code #

1. Public Land Survey	T 44N R 1E	J-13	Same
	T 43N R 1E	J-1	Corner
	T _____ R _____		
	T _____ R _____		
2. Property Controlling in Section	S _____ T _____ R _____		
	S _____ T _____ R _____		
3. Miscellaneous Property in Sec.	S _____ T _____ R _____		
	S _____ T _____ R _____		

J. Roger Matlak  
REGISTER OF DEEDS

Register of Deeds Stamp & File Number

- 4. Lot No. \_\_\_\_\_, Recorded Plat \_\_\_\_\_
- 5. Private Claims \_\_\_\_\_

A	B	C	D	E	F	G	H	I	J	K	L	M
2	6	5	4	3	2							
3												
4	7	8	9	10	11	12						
5												
6	18	17	16	15	14	13						
7												
8	19	20	21	22	23	24						
9												
10	30	29	28	27	26	25						
11												
12	31	32	33	34	35	36						
13												


I, William L. Karr, in a field survey on December 6, 19 93, do hereby certify that under requirements of P.A. 74, Michigan P.A. of 1970, the corner points mentioned in lines 1 and 2 above were in conformance with regulations and rules therefore as required in the current manual of survey instructions of the United States Department of the Interior, Bureau of Land Management or by a decree of a Court of Law and/or that the corner points mentioned in lines 3, 4 and 5 above were in conformance with the rules of the Michigan Board of Land Surveyors or by a Decree of a Court of Law; established, re-established, monumented, re-monumented, recovered, found as expressed below:

NOTE: Not more than 4 corners, all in the same town and range, may be recorded on this certificate.

A. Description of original monument and accessories and/or subsequent restoration:  
(J-13) 1/4 Corner Common to Sections 35 & 2 (T44N-R1E)

1930: C.M. Cade, CE. Department of Conservation Survey of Munuskong Bay State Park. Set I.P. and Witness Monument North 33' (Number 28 on survey drawing). Survey shows corner set midway and on line between Section corners.

1960: Chippewa County Road Commission. Corner recorded in Liber 3, Page 43 of the Chippewa County Corner Records. Call for a concrete monument in steel from 33' to the North. (No description of actual corner).

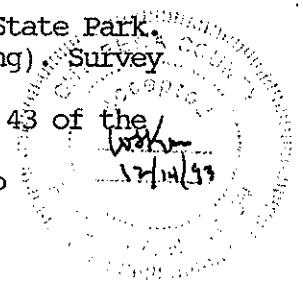

B. Description of corner evidence found and/or method applied in restoring or reestablishing corner:

(J-13) This corner is being perpetuated as part of the Chippewa County Remonumentation Program.

Found a 1 1/2" O.D. pipe 8" below paved road surface. Falls on the extension of a fence line to the South. Found 4" diameter concrete filled pipe with stamped brass tablet "State of Michigan No. 28". Distance East to the Southeast corner of Section 35 is 2642.72' (Cade - 2644.2). Distance West to the Southwest corner of Section 35 is 2642.01' (Cade - 2644.2) Corner is 0.71' South of a straight line between said Section Corners. Accepted corner position as found. Offset corner position prior to road reconstruction. Replaced corner after construction completed. Rewitnessed corner.

C. Description of monument for corner and accessories established to perpetuate locating the position of the corner:

(J-13) Corner is a 3/4" x 8" iron with plastic "Chippewa County Remonumentation" cap. Corner falls 1' South of centerline Gogomain Road (East-West, paved). Falls on the extension of a fence line to the South.

Witnesses:

4" Diameter Witness Monument	North	33.11' (existing)
Power Pole PD2/55/37	S74°E	165.95'
Corner Fence Post	South	66.34'
9" Scotch Pine	S34°W	75.89'
10" Scotch Pine	S68°W	138.04'



Signed by William L. Karr Date 12/23/93

Surveyor's Michigan License No. 27450

NOTE: Bearings are compass bearings corrected for declination. Distances are to a nail in side of witness objects unless noted.