

MAR 09 1994

COMMISSION

Chippewa County Remonumentation Corner

LAND CORNER RECORDATION CERTIFICATE
Filing Requirement of Act 74, Mich. P.A. 1970

RECEIVED FOR RECORD
CHIPPewa COUNTY
STATE OF MICHIGAN

93 DEC 29 PM 2:48

J. Roger Malott
REGISTER OF DEEDS

For corners in
Chippewa

(County)

Located In:


Corner Code #

1. Public Land Survey	T	<u>44N</u> R	<u>1E</u>	<u>L-13</u> Same
	T	<u>43N</u> R	<u>1E</u>	<u>L-1</u> Corner
	T	_____ R	_____	_____
	T	_____ R	_____	_____
2. Property Controlling in Section	S	_____ T	_____ R	_____
	S	_____ T	_____ R	_____
3. Miscellaneous Property in Sec.	S	_____ T	_____ R	_____
	S	_____ T	_____ R	_____

Register of Deeds Stamp & File Number

4. Lot No. _____, Recorded Plat _____
5. Private Claims _____

I, William L. Karr, in a field survey on December 6, 19 93, do hereby certify that under requirements of P.A. 74, Michigan P.A. of 1970, the corner points mentioned in lines 1 and 2 above were in conformance with regulations and rules therefore as required in the current manual of survey instructions of the United States Department of the Interior, Bureau of Land Management or by a decree of a Court of Law and/or that the corner points mentioned in lines 3, 4 and 5 above were in conformance with the rules of the Michigan Board of Land Surveyors or by a Decree of a Court of Law; established, re-established, monumented, re-monumented, recovered, found as expressed below:

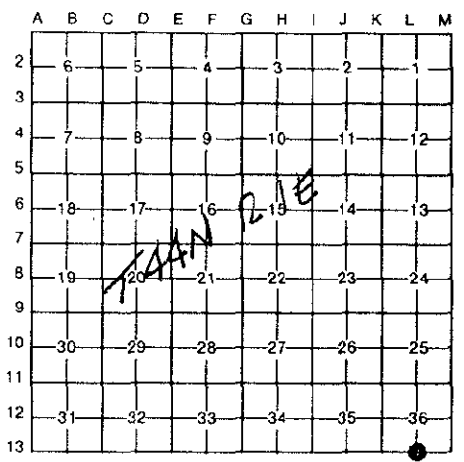


NOTE: Not more than 4 corners, all in the same town and range, may be recorded on this certificate.

A. Description of original monument and accessories and/or subsequent restoration:
(L-13) 1/4 Corner Common to Sections 36 & 1 (T44N R1E)

1930: C.M. Cade, C.E., Department of Conservation Survey of Munuskong Bay State Park.

Set an I.P. and Witness Monument North 33' (Number 30 on survey drawing).
Survey shows corner set midway and on line between Section corners.

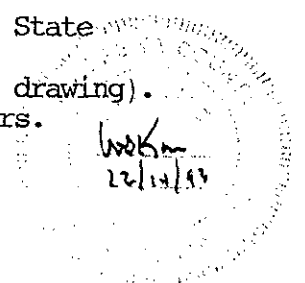

B. Description of corner evidence found and/or method applied in restoring or reestablishing corner:
(L-13) This corner is being perpetuated as part of the Chippewa County Remonumentation Program.

Found a PK nail. Found a 4" diameter concrete filled pipe with stamped brass tablet "State of Michigan No. 30" 32.98' North of the PK nail. Distance East to the Southeast corner of Section 36 is 2647.82' (Cade - 2647.3). Distance West to the Southwest corner of Section 36 is 2644.95' (Cade - 2647.3). Corner is 0.51' South of a straight line between said Section corners. Accepted corner position as found. Offset corner position prior to road reconstruction. Replaced corner after construction completed.

C. Description of monument for corner and accessories established to perpetuate locating the position of the corner:
(L-13) Corner is a 3/4" x 24" iron with plastic "Chippewa County Remonumentation" cap. Corner falls 1.5' North of centerline of Gogomain Road (East-West, paved).

Witnesses:

4" Diameter Witness Monument	North	32.98'
10" Spruce	N40°E	53.76'
9" Tamarack	S26°E	61.52'
"V" Notch in East End 24" C.M.P.	S64°W	86.65'
7" Cedar	N36°W	41.10'



Signed by William L. Karr Date 12/23/93

Surveyor's Michigan License No. 27450

NOTE: Bearings are compass bearings corrected for declination.
Distances are to a nail in side of witness objects unless noted.