

MAR 09 1994

COMMISSION

**Chippewa County Remonumentation Corner**

RECEIVED FOR RECORD  
CHIPPEWA COUNTY  
STATE OF MICHIGAN

**LAND CORNER RECORDATION CERTIFICATE**  
Filing Requirement of Act 74, Mich. P.A. 1970

93 DEC 29 PM 2:47

For corners in

Chippewa

(County)

Located In:

Corner Code #

1. Public Land Survey	T	44N	R	1E	C-13 Same
	T	43N	R	1E	C-1 Corner
	T		R		
	T		R		
2. Property Controlling in Section	S		T	R	
	S		T	R	
3. Miscellaneous Property in Sec.	S		T	R	
	S		T	R	

*J. Roger Malott*  
REGISTER OF DEEDS

Register of Deeds Stamp & File Number

4. Lot No. \_\_\_\_\_, Recorded Plat \_\_\_\_\_  
5. Private Claims \_\_\_\_\_

	A	B	C	D	E	F	G	H	I	J	K	L	M
2	6	5	4	3	2	1							
3													
4	7	8	9	10	11	12							
5													
6	18	17	16	15	14	13							
7													
8	19	20	21	22	23	24							
9													
10	30	29	28	27	26	25							
11													
12	31	32	33	34	35	36							
13													

I, William L. Karr, in a field survey on December 1, 1993

do hereby certify that under requirements of P.A. 74, Michigan P.A. of 1970, the corner points mentioned in lines 1 and 2 above were in conformance with regulations and rules therefore as required in the current manual of survey instructions of the United States Department of the Interior, Bureau of Land Management or by a decree of a Court of Law and/or that the corner points mentioned in lines 3, 4 and 5 above were in conformance with the rules of the Michigan Board of Land Surveyors or by a Decree of a Court of Law; established, re-established, monumented, re-monumented, recovered, found as expressed below:


**NOTE: Not more than 4 corners, all in the same town and range, may be recorded on this certificate.**

A. Description of original monument and accessories and/or subsequent restoration:

(C-13) Section Corner Common to Sections 31, 32, 5 & 6 (T44N-R1E)

1840: Corner established by Austin Burt for William A. Burt.

Undated: County Surveyor Records call for bolt with nut on top and steel post and Cedar 4" x 3.5'. Various County Surveyor Section drawings for the area.

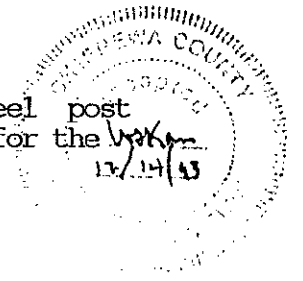

B. Description of corner evidence found and/or method applied in restoring or reestablishing corner:

(C-13) This corner is being perpetuated as part of the Chippewa County Remonumentation Program.

Found a 3/4" iron at road intersection. Distance West to the South 1/4 Corner of Section 31 is 2646.10' (County Surveyor - 2649'). Distance East to the Southeast corner of Section 32 is 5295.26 (County Surveyor - 5291'). Accepted corner position as found. Offset corner position prior to road reconstruction work. Replaced corner after construction completed.

C. Description of monument for corner and accessories established to perpetuate locating the position of the corner:

(C-13) Corner is a 3/4" x 9" iron with plastic "Chippewa County Remonumentation" cap. Corner falls on centerline Gogomain Road (East-West, paved) and on centerline of County Road to the North (North-South, gravel). Falls 5' West of centerline County Road to the South (North-South, gravel).

Witnesses:

"V" Cut in East End 18" C.M.P.	N25°E	42.34'
8" Spruce	S77°E	130.22'
11" Spruce	S64°W	84.56'
Power Pole PD2/54/12N	N37°W	67.78'



Signed by William L. Karr Date 12/29/93

Surveyor's Michigan License No. 27450

NOTE: Bearings are compass bearings corrected for declination.  
Distances are to a nail in side of witness objects unless noted.