

SURVEY & REMONUMENTATION

MAR 09 1994

COMMISSION

RECEIVED FOR RECORD
CHIPPEWA COUNTY
STATE OF MICHIGAN

Chippewa County Remonumentation Corner

LAND CORNER RECORDATION CERTIFICATE 93 DEC 29 AM 10:28
Filing Requirement of Act 74, Mich. P.A. 1970


J. Roger Mallett
REGISTER OF DEEDS

For corners in
Chippewa
(County)

	Located In:	Corner Code #
1. Public Land Survey	T <u>44N</u> R <u>1E</u>	<u>D-9</u>
	T _____ R _____	_____
	T _____ R _____	_____
	T _____ R _____	_____
2. Property Controlling in Section	S _____ T _____ R _____	_____
	S _____ T _____ R _____	_____
3. Miscellaneous Property in Sec.	S _____ T _____ R _____	_____
	S _____ T _____ R _____	_____
4. Lot No. _____, Recorded Plat _____		
5. Private Claims _____		

Register of Deeds Stamp & File Number

I, Larry R. Rogers, in a field survey on November 18, 19 93, do hereby certify that under requirements of P.A. 74, Michigan P.A. of 1970, the corner points mentioned in lines 1 and 2 above were in conformance with regulations and rules therefore as required in the current manual of survey instructions of the United States Department of the Interior, Bureau of Land Management or by a decree of a Court of Law and/or that the corner points mentioned in lines 3, 4 and 5 above were in conformance with the rules of the Michigan Board of Land Surveyors or by a Decree of a Court of Law; established, re-established, monumented, re-monumented, recovered, found as expressed below:

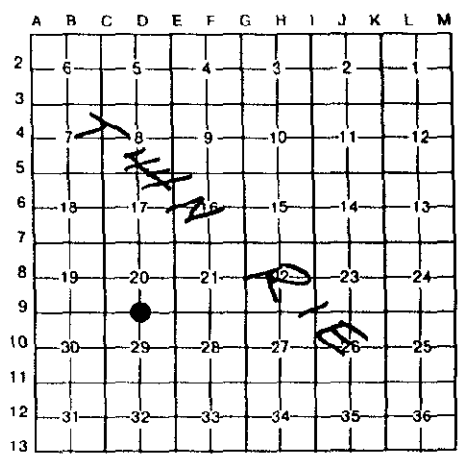

NOTE: Not more than 4 corners, all in the same town and range, may be recorded on this certificate.

A. Description of original monument and accessories and/or subsequent restoration:
(D-9) 1/4 Corner Common to Sections 20 and 29, T44N-R1E

Original Notes : 3 October 1849, John Mullett.
Set Quarter Section Post
8" Spruce N42°E 13 links
12" Tamarack S35°E 12 links


Undated Survey Notes (Circa 1905) refer to corner as iron bar.

B. Description of corner evidence found and/or method applied in restoring or reestablishing corner:
(D-9) This corner is being perpetuated as part of the Chippewa County Remonumentation Program.

Found no evidence of original corner position or subsequent restoration. Corner position was re-established on a line between the Southeast and Southwest corners of Section 20 at a pro-rated distance based on County Surveyor notes. Distance between the Southeast and Southwest corners of Section 20 is about 10' short of County Surveyor distance, but re-established position falls on extension of an old fence line to the South.

C. Description of monument for corner and accessories established to perpetuate locating the position of the corner:
(D-9) Corner is a 3/4" x 24" iron pin with plastic remonumentation cap, 2.8' South of the centerline of Riverside Drive (Twenty-two Mile Road).

Witnesses: Fence Post	N45°W	86.98'
Utility Pole (PD2/10)	N62°E	108.56'
Utility Pole	S45°E	68.56'
Corner Fence Post	S02°E	47.25'

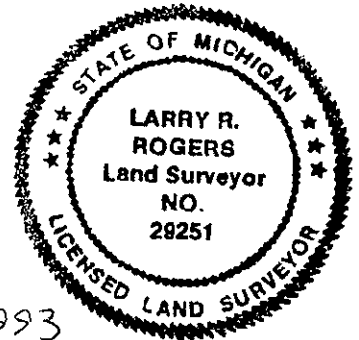

Signed by *Larry R. Rogers*
Surveyor's Michigan License No. 29251

Date 22 DEC 1993

NOTE: Bearings are compass bearings corrected for declination.
Distances are to a nail in side of witness objects unless noted.