

MAR 09 1994

COMMISSION

Chippewa County Remonumentation Corner

RECEIVED FOR RECORD
CHIPPEWA COUNTY
STATE OF MICHIGAN

LAND CORNER RECORDATION CERTIFICATE
Filing Requirement of Act 74, Mich. P.A. 1970

93 DEC 29 AM 10:28

For corners in
Chippewa


Located In: Corner Code #

1. Public Land Survey	T <u>44N</u> R <u>1E</u>	<u>F-9</u>
	T ___ R ___	_____
	T ___ R ___	_____
	T ___ R ___	_____
	T ___ R ___	_____
2. Property Controlling in Section	S ___ T ___ R ___	_____
	S ___ T ___ R ___	_____
3. Miscellaneous Property in Sec.	S ___ T ___ R ___	_____
	S ___ T ___ R ___	_____

J. Roger Malott
REGISTER OF DEEDS

Register of Deeds Stamp & File Number

4. Lot No. _____, Recorded Plat _____
5. Private Claims _____

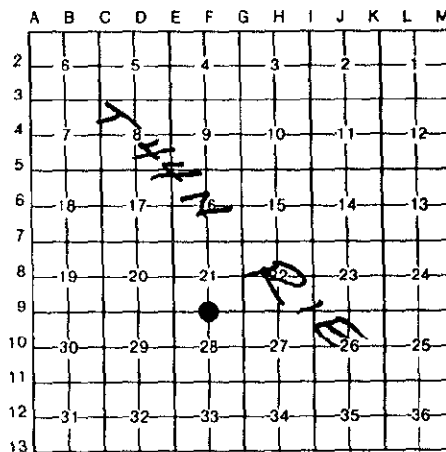

I, Larry R. Rogers, in a field survey on November 18, 19 93, do hereby certify that under requirements of P.A. 74, Michigan P.A. of 1970, the corner points mentioned in lines 1 and 2 above were in conformance with regulations and rules therefore as required in the current manual of survey instructions of the United States Department of the Interior, Bureau of Land Management or by a decree of a Court of Law and/or that the corner points mentioned in lines 3, 4 and 5 above were in conformance with the rules of the Michigan Board of Land Surveyors or by a Decree of a Court of Law; established, re-established, monumented, re-monumented, recovered, found as expressed below:

NOTE: Not more than 4 corners, all in the same town and range, may be recorded on this certificate.

A. Description of original monument and accessories and/or subsequent restoration:
(F-9) 1/2 Corner Common to Sections 21 & 28 (T44N-R1E)

Original Survey Notes: 3 October 1845, John Mullett.
Set Quarter Section Post
8" Fir N75°W 6 links
8" Fir S22°E 4 links

County Surveyor notes from 1905± measure the South line of section as 5338'.




B. Description of corner evidence found and/or method applied in restoring or reestablishing corner:
(F-9) This corner is being perpetuated as part of the Chippewa County Remonumentation Program.

Found no evidence of original corner position. South line of Section measures 5341.44' (5338' County Surveyor). Found 1/2" iron pin set by Ron Bischer, P.S. 22428, in a survey dated 11/8/90. Corner falls on approximate centerline of gravel road to the North and on the extension of new fence to the South. Accepted corner position as found.

C. Description of monument for corner and accessories established to perpetuate locating the position of the corner:
(F-9) Corner is a 1/2" iron pin in the centerline of Riverside Drive (Twenty-two Mile Road).

Witnesses: Corner Fence Post	N19°E	52.39'
End Fence Post	S01°W	56.18'
Corner Fence Post	N27°W	61.31'
Utility Pole	N51°W	94.17'

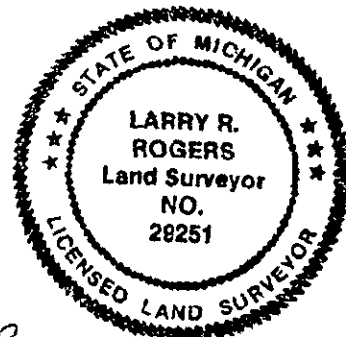

Signed by [Signature] 29251

Date 23 DEC 1993

Surveyor's Michigan License No. _____
NOTE: Bearings are compass bearings corrected for declination.
Distances are to a nail in side of witness objects unless noted.