

MAR 09 1994

Chippewa County Remonumentation Corner

RECEIVED FOR RECORD
CHIPPEWA COUNTY
STATE OF MICHIGAN

COMMISSION

LAND CORNER RECORDATION CERTIFICATE

Filing Requirement of Act 74, Mich. P.A. 1970

93 DEC 29 AM 10:28

For corners in

Chippewa

(County)

Located In:

Corner Code #


1. Public Land Survey	T <u>44N</u> R <u>1E</u>	<u>G-7</u>
	T _____ R _____	_____
	T _____ R _____	_____
	T _____ R _____	_____
2. Property Controlling in Section	S _____ T _____ R _____	_____
	S _____ T _____ R _____	_____
3. Miscellaneous Property in Sec.	S _____ T _____ R _____	_____
	S _____ T _____ R _____	_____

J. Roger Malott

REGISTER OF DEEDS

Register of Deeds Stamp & File Number

4. Lot No. _____, Recorded Plat _____
5. Private Claims _____

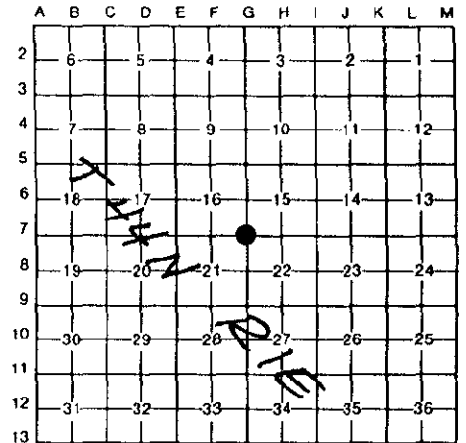

I, Larry R. Rogers, in a field survey on November 22, 19 93, do hereby certify that under requirements of P.A. 74, Michigan P.A. of 1970, the corner points mentioned in lines 1 and 2 above were in conformance with regulations and rules therefore as required in the current manual of survey instructions of the United States Department of the Interior, Bureau of Land Management or by a decree of a Court of Law and/or that the corner points mentioned in lines 3, 4 and 5 above were in conformance with the rules of the Michigan Board of Land Surveyors or by a Decree of a Court of Law; established, re-established, monumented, re-monumented, recovered, found as expressed below:

NOTE: Not more than 4 corners, all in the same town and range, may be recorded on this certificate.

A. Description of original monument and accessories and/or subsequent restoration:
(G-7) Section Corner Common to Sections 15, 16, 21 & 22 (T44N-R1E)

Corner referred to in 1930 survey by C.M. Cade as "Wood & Cem." with five witnesses. The Chippewa County Road Commission found a 6" post in 1971 and recorded it in Liber 3, Page 303 of the Chippewa County Corner Records. In 1972, B.D. Buckler (M.D.N.R.) found post by Cade and set 1/2" iron in it and recorded it in Liber 1, Page 46. Corner was removed by the Road Commission during reconstruction of Riverside Drive.

B. Description of corner evidence found and/or method applied in restoring or reestablishing corner:


(G-7) This corner is being perpetuated as part of the Chippewa County Remonumentation Program.

All witnesses from previous restoration have been removed. Found 6" spike 4" below grade at intersecting centerlines of Riverside Drive and Twenty-one Mile Road. Also found severely bent iron pipe 3' deep and approximately 4' Northeast of spike. Pipe has been disturbed, probably during reconstruction of Riverside Drive. Distances from spike to Section corners 1 mile to North and South match very well with distances from 1930 Cade survey. Replaced spike with 3/4" x 24" iron and established new witnesses.

C. Description of monument for corner and accessories established to perpetuate locating the position of the corner:

(G-7) Corner is a 3/4" x 24" iron pin with plastic remonumentation cap in centerline of Riverside Drive and Twenty-one Mile Road.

Witnesses: 7" Maple	N35°W	74.50'
6" Tamarack	S80°W	69.32'
Corner Fence Post	S54°W	57.04'
8" Balsam Fir	S80°E	113.41'
27" Spruce	N66°E	113.13'
12" Spruce	N40°E	66.74'

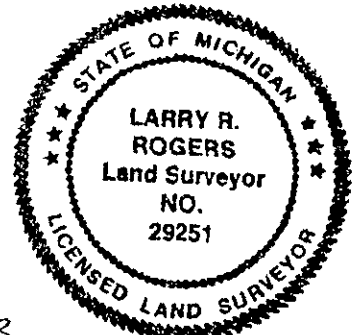

Signed by *Larry R. Rogers*

Date 23 Dec 1993

Surveyor's Michigan License No. 29251

NOTE: Bearings are compass bearings corrected for declination.

Distances are to a nail in side of witness objects unless noted.