

MAR 09 1994

Chippewa County Remonumentation Corner

RECEIVED FOR RECORD  
CHIPPEWA COUNTY  
STATE OF MICHIGAN

LAND CORNER RECORDATION CERTIFICATE

93 DEC 29 AM 10:28

Filing Requirement of Act 74, Mich. P.A. 1970

COMMISSION


*J. Roger Malott*  
REGISTER OF DEEDS

For corners in  
Chippewa

(County)	Located In:	Corner Code #
1. Public Land Survey	T <u>44N</u> R <u>1E</u>	<u>G-9</u>
	T _____ R _____	_____
	T _____ R _____	_____
	T _____ R _____	_____
2. Property Controlling in Section	S _____ T _____ R _____	_____
	S _____ T _____ R _____	_____
3. Miscellaneous Property in Sec.	S _____ T _____ R _____	_____
	S _____ T _____ R _____	_____
4. Lot No. _____, Recorded Plat _____		
5. Private Claims _____		

Register of Deeds Stamp & File Number

I, Larry R. Rogers, in a field survey on November 19, 19 93 do hereby certify that under requirements of P.A. 74, Michigan P.A. of 1970, the corner points mentioned in lines 1 and 2 above were in conformance with regulations and rules therefore as required in the current manual of survey instructions of the United States Department of the Interior, Bureau of Land Management or by a decree of a Court of Law and/or that the corner points mentioned in lines 3, 4 and 5 above were in conformance with the rules of the Michigan Board of Land Surveyors or by a Decree of a Court of Law; established, re-established, monumented, re-monumented, recovered, found as expressed below:

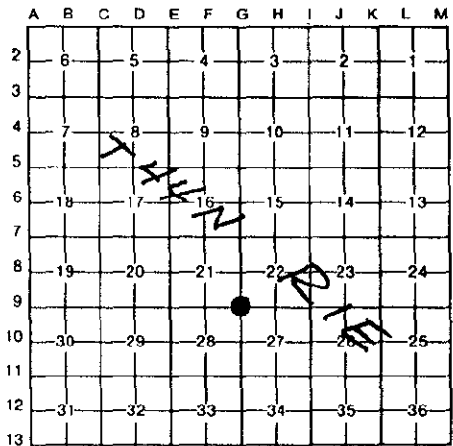

**NOTE: Not more than 4 corners, all in the same town and range, may be recorded on this certificate.**

A. Description of original monument and accessories and/or subsequent restoration:  
(G-9) Section Corner Common to Sections 21, 22, 27 & 28 (T44N-R1E)


This corner was found by C.M. Cade in 1930 as part of a survey of the Munoscong State Forest. Chippewa County Road Commission found Cade corner is 1970, replaced it with a 1" x 18" iron pipe and recorded it in Liber 3, Page 191 of the Chippewa County Corner Records. Pipe was found in 1984 by W.L. Karr, P.S. 27450. Corner was removed by the Road Commission during reconstruction of Riverside Drive and replaced in 1990 by R. Bischer, P.S. 22428.

B. Description of corner evidence found and/or method applied in restoring or reestablishing corner:  
(G-9) This corner is being perpetuated as part of the Chippewa County Remonumentation Program.

Found Bischer iron and witnesses from 1990 survey. Corner position matches position tied in during 1984 survey by Karr. Position matches distances to the North and East from 1930 Cade survey. Accepted corner position as found and established three new witnesses.

C. Description of monument for corner and accessories established to perpetuate locating the position of the corner:  
(G-9) Corner is a 1/2" iron pin in intersecting centerlines of Riverside Drive to the North and West.

Witnesses: Utility Pole (PD2/21/16)	N62°E	63.85'
Anchor Pole	S54°E	65.57'
Corner Fence Post	N40°W	69.54'
Utility Pole	S53°W	82.68'
"V" Cut in West End C.M.P.	S25°W	49.20'

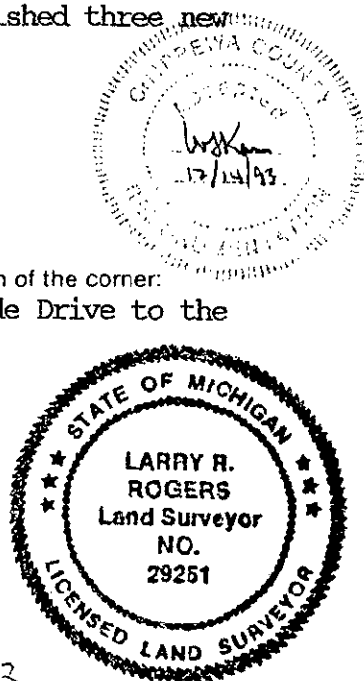

Signed by *Larry R. Rogers*  
Surveyor's Michigan License No. 29251

Date 23 Dec 1993

NOTE: Bearings are compass bearings corrected for declination.  
Distances are to a nail in side of witness objects unless noted.