

MAR 08 1994

COMMISSION

Chippewa County Remonumentation Corner

LAND CORNER RECORDATION CERTIFICATE

Filing Requirement of Act 74, Mich. P.A. 1970

RECEIVED FOR RECORD
CHIPPWEA COUNTY
STATE OF MICHIGAN

93 DEC 29 PM 2:48

J. Roger Madole
REGISTER OF DEEDS

For corners in
Chippewa

(County)


Located In:

Corner Code ##

1. Public Land Survey	T <u>44N</u> R <u>1E</u>	<u>G-13</u> Same
	T <u>43N</u> R <u>1E</u>	<u>G-1</u> Corner
	T _____ R _____	_____
	T _____ R _____	_____
2. Property Controlling in Section	S _____ T _____ R _____	_____
	S _____ T _____ R _____	_____
3. Miscellaneous Property in Sec.	S _____ T _____ R _____	_____
	S _____ T _____ R _____	_____

Register of Deeds Stamp & File Number

- 4. Lot No. _____, Recorded Plat _____
- 5. Private Claims _____

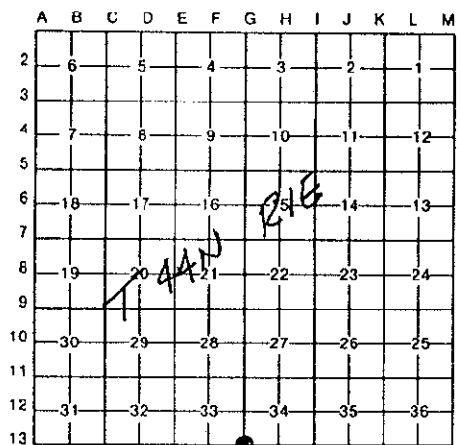


I, William L. Karr, in a field survey on December 1, 19 93, do hereby certify that under requirements of P.A. 74, Michigan P.A. of 1970, the corner points mentioned in lines 1 and 2 above were in conformance with regulations and rules therefore as required in the current manual of survey instructions of the United States Department of the Interior, Bureau of Land Management or by a decree of a Court of Law and/or that the corner points mentioned in lines 3, 4 and 5 above were in conformance with the rules of the Michigan Board of Land Surveyors or by a Decree of a Court of Law; established, re-established, monumented, re-monumented, recovered, found as expressed below:

NOTE: Not more than 4 corners, all in the same town and range, may be recorded on this certificate.

A. Description of original monument and accessories and/or subsequent restoration:
(G-13) Section Corner Common to Sections 33, 34, 3 & 4, (T44N-R1E)

- 1993: G. A. Meyers, L.S. 28418. Corner recorded in Liber 8, Page 7 of the Chippewa County Corner Records. Found a PK nail and replaced it with a 1/2" iron, L.S. #28418.
- Utility Pole S23°W 60.18'
- Bell Box Support Post S33°E 58.71'
- Corner Fence Post N31°E 55.86'
- Anchor Pole N26°W 48.37'
- Existing Iron S36°E 57.57'

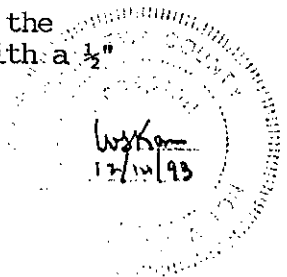

B. Description of corner evidence found and/or method applied in restoring or reestablishing corner:
(G-13) This corner is being perpetuated as part of the Chippewa County Remonumentation Program.

Found a 1/2" iron L.S. 28418 at road intersection. Found the five recorded witness objects. Accepted corner position as found. Offset corner position prior to road reconstruction work. Replaced corner after construction completed.

C. Description of monument for corner and accessories established to perpetuate locating the position of the corner:
(G-13) Corner is a 3/4" x 24" iron with plastic "Chippewa County Remonumentation" cap. Corner falls 0.5' south of the centerline of Gogomain Road (East-West, paved). Falls 3' West of the centerline of Hewer Road to the South (North-South, gravel). Falls on approximate centerline of an old road to the North.

Witnesses:

- Corner Fence Post N31°E 55.89' (existing nail)
- 1/2" Iron S36°E 57.57' (existing)
- Bell Box Support Post (Cut-off Power Pole) S33°E 58.80' (existing nail)
- Power Pole PD2/55/3 S23°W 60.19' (existing nail)
- Anchor Pole N26°W 48.40' (existing nail)

Signed by William L. Karr Date 12/23/93

Surveyor's Michigan License No. 27450



NOTE: Bearings are compass bearings corrected for declination. Distances are to a nail in side of witness objects unless noted.