

MAR 09 1994

Chippewa County Remonumentation Corner

RECEIVED FOR RECORD
CHIPPEWA COUNTY
STATE OF MICHIGAN

COMMISSIONER

LAND CORNER RECORDATION CERTIFICATE

93 DEC 29 AM 10:27

Filing Requirement of Act 74, Mich. P.A. 1970

For corners in

Chippewa

(County)

Located In:

Corner Code #

- | | | |
|------------------------------------|--------------------------|------------|
| 1. Public Land Survey | T <u>44N</u> R <u>1E</u> | <u>H-3</u> |
| | T _____ R _____ | _____ |
| | T _____ R _____ | _____ |
| | T _____ R _____ | _____ |
| 2. Property Controlling in Section | S _____ T _____ R _____ | _____ |
| | S _____ T _____ R _____ | _____ |
| 3. Miscellaneous Property in Sec. | S _____ T _____ R _____ | _____ |
| | S _____ T _____ R _____ | _____ |


J. Roger Malotte

REGISTER OF DEEDS

Register of Deeds Stamp & File Number

4. Lot No. _____, Recorded Plat _____
5. Private Claims _____

I, Larry R. Rogers, in a field survey on November 15, 19 93, do hereby certify that under requirements of P.A. 74, Michigan P.A. of 1970, the corner points mentioned in lines 1 and 2 above were in conformance with regulations and rules therefore as required in the current manual of survey instructions of the United States Department of the Interior, Bureau of Land Management or by a decree of a Court of Law and/or that the corner points mentioned in lines 3, 4 and 5 above were in conformance with the rules of the Michigan Board of Land Surveyors or by a Decree of a Court of Law; established, re-established, monumented, re-monumented, recovered, found as expressed below:

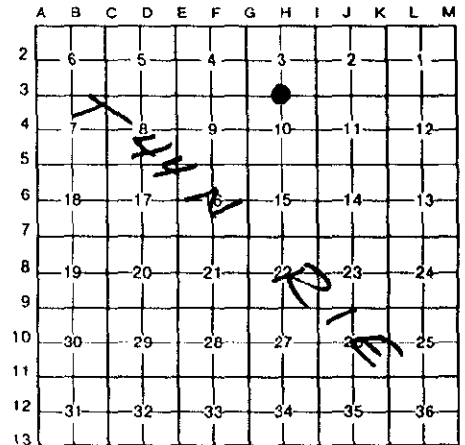

NOTE: Not more than 4 corners, all in the same town and range, may be recorded on this certificate.

A. Description of original monument and accessories and/or subsequent restoration:
(H-3) 1/2 Corner Common to Sections 3 & 10 (T44N-R1E)

In 1930, C.M. Cade set a concrete monument under the bridge as part of a survey of the Munoscong State Forest, with the following witnesses:

- | | | |
|------------|-------|-------|
| 12" Spruce | N30°W | 93.2' |
| 8" Birch | N12°E | 58.0' |

B. Description of corner evidence found and/or method applied in restoring or reestablishing corner:

(H-3) This corner is being perpetuated as part of the Chippewa County Remonumentation Program.

Found 1930 Cade monument - a 4" concrete filled iron pipe with brass cap stamped "State of Michigan No. 13". Corner is 18" above grade and approximately 15' East of the West bank of the Little Munoscong River. Bridge has been removed and the 1930 witnesses are gone. Distance to the Northeast corner of Section 10 matches 1930 Cade survey. Accepted corner position as found and established new witnesses.

C. Description of monument for corner and accessories established to perpetuate locating the position of the corner:

(H-3) Corner is a 4" concrete filled pipe with brass cap.

- | | | |
|-------------------------------------|-----------|--------|
| Witnesses: 8" Spruce | N30°E | 32.06' |
| 6" White Birch | N31°E | 6.83' |
| Utility Pole with Transformer | S70°E | 62.59' |
| 8" Balsam Poplar | Due South | 19.59' |
| East Bank of Little Munoscong River | West | 15'± |



Signed by *[Signature]*
Surveyor's Michigan License No. 29251

Date 23 Dec 1993

NOTE: Bearings are compass bearings corrected for declination.
Distances are to a nail in side of witness objects unless noted.