

MAR 09 1994

Chippewa County Remonumentation Corner

RECEIVED FOR RECORD
CHIPPEWA COUNTY
STATE OF MICHIGAN

COMMISSION

LAND CORNER RECORDATION CERTIFICATE
Filing Requirement of Act 74, Mich. P.A. 1970

93 DEC 29 AM 10:27

For corners in
Chippewa

(County)

Located In:


Corner Code #:

1. Public Land Survey	T <u>44N</u> R <u>1E</u>	<u>I-2</u>
	T _____ R _____	_____
	T _____ R _____	_____
	T _____ R _____	_____
2. Property Controlling in Section	S _____ T _____ R _____	_____
	S _____ T _____ R _____	_____
3. Miscellaneous Property in Sec.	S _____ T _____ R _____	_____
	S _____ T _____ R _____	_____

J. Roger Malott
REGISTER OF DEEDS

Register of Deeds Stamp & File Number

- 4. Lot No. _____, Recorded Plat _____
- 5. Private Claims _____

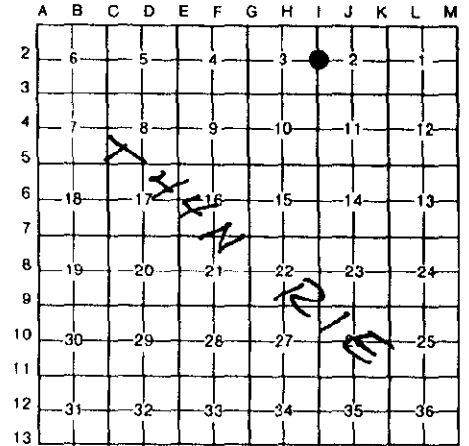

I, Larry R. Rogers, in a field survey on November 15, 19 93, do hereby certify that under requirements of P.A. 74, Michigan P.A. of 1970, the corner points mentioned in lines 1 and 2 above were in conformance with regulations and rules therefore as required in the current manual of survey instructions of the United States Department of the Interior, Bureau of Land Management or by a decree of a Court of Law and/or that the corner points mentioned in lines 3, 4 and 5 above were in conformance with the rules of the Michigan Board of Land Surveyors or by a Decree of a Court of Law; established, re-established, monumented, re-monumented, recovered, found as expressed below:

NOTE: Not more than 4 corners, all in the same town and range, may be recorded on this certificate.

A. Description of original monument and accessories and/or subsequent restoration:
(I-2) 1/4 Corner Common to Sections 2 & 3 (T44N-R1E)


An iron pipe was set midway and on line between the Northeast and Southeast corners of Section 3 by C.M. Cade as part of a 1930 survey of the Munoscong State Forest with the following witnesses:

Pole	N41°E	29.4'
10" Poplar	S46°W	44.8'
6" Poplar	S78°W	46.7'
5 Spruce	S10°E	88.0'
Witness Monument (#11)	East	33.0'

B. Description of corner evidence found and/or method applied in restoring or reestablishing corner:

(I-2) This corner is being perpetuated as part of the Chippewa County Remonumentation Program.

Found Cade Witness Monument but no evidence of 1/4 Corner or other Cade witnesses. Reset 1/4 Corner midway and on line between the Northeast and Southeast corners of Section 3. Position checks with Witness Monument. Established four new witnesses.

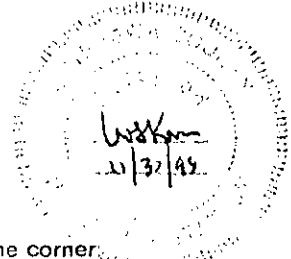

C. Description of monument for corner and accessories established to perpetuate locating the position of the corner:
(I-2) Corner is a 3/4" x 24" iron with plastic remonumentation cap, in Riverside Drive.

Witnesses: D.N.R. Witness Monument	East	33.12'
5" Spruce	N80°E	51.32'
10" Poplar	S43°E	50.16'
12" Spruce	S80°W	51.86'
16" Spruce	S15°W	147.24'



Signed by [Signature] Date 23 Dec 1993

Surveyor's Michigan License No. 29251

NOTE: Bearings are compass bearings corrected for declination.
Distances are to a nail in side of witness objects unless noted.