

MAR 08 1994

Chippewa County Remonumentation Corner

RECEIVED FOR RECORD
CHIPPEWA COUNTY
STATE OF MICHIGAN

93 DEC 29 PM 2:48

COMMISSION

LAND CORNER RECORDATION CERTIFICATE
Filing Requirement of Act 74, Mich. P.A. 1970

For corners in
Chippewa

(County)

Located In:

Corner Code #

1. Public Land Survey	T <u>44N</u> R <u>1E</u>	<u>(I-13)</u> Same
	T <u>43N</u> R <u>1E</u>	<u>I-1</u> / Corner
	T _____ R _____	_____
	T _____ R _____	_____
2. Property Controlling in Section	S _____ T _____ R _____	_____
	S _____ T _____ R _____	_____
3. Miscellaneous Property in Sec.	S _____ T _____ R _____	_____
	S _____ T _____ R _____	_____

J. Roger Malott
REGISTER OF DEEDS

Register of Deeds Stamp & File Number

4. Lot No. _____, Recorded Plat _____
5. Private Claims _____

A	B	C	D	E	F	G	H	I	J	K	L	M
2	6	5	4	3	2	1						
3												
4	7	8	9	10	11	12						
5												
6	18	17	16	15	14	13						
7												
8	19	20	21	22	23	24						
9												
10	30	29	28	27	26	25						
11												
12	31	32	33	34	35	36						
13												

I, William L. Karr, in a field survey on December 3, 19 93, do hereby certify that under requirements of P.A. 74, Michigan P.A. of 1970, the corner points mentioned in lines 1 and 2 above were in conformance with regulations and rules therofore as required in the current manual of survey instructions of the United States Department of the Interior, Bureau of Land Management or by a decree of a Court of Law and/or that the corner points mentioned in lines 3, 4 and 5 above were in conformance with the rules of the Michigan Board of Land Surveyors or by a Decree of a Court of Law; established, re-established, monumented, re-monumented, recovered, found as expressed below:

NOTE: Not more than 4 corners, all in the same town and range, may be recorded on this certificate.

A. Description of original monument and accessories and/or subsequent restoration:

(I-13) Section Corner Common to Sections 34, 35, 2 & 3 (T44N-R1E)

1960: Chippewa County Road Commission. Corner recorded in Liber 3, Page 43 of the Chippewa County Corner Records.

Concrete monument 33.0' North (No description of actual corner).

1993: G.A. Meyers, L.S. 28418. Corner recorded in Liber 8, Page 1 of the Chippewa County Corner Records. Found 1 1/2" iron pipe.

Power Pole	S25°W	89.28'
10" White Pine	N05°W	57.32'
10" Spruce	S81°E	147.70'

*with
12/14/93*

B. Description of corner evidence found and/or method applied in restoring or reestablishing corner:

(I-13) This corner is being perpetuated as part of the Chippewa County Remonumentation Program.


Found 1 1/2" O.D. pipe with PK nail in it. Found 4" diameter concrete filled pipe with stamped brass tablet "State of Michigan No. 27". Monument is a Witness Monument from a 1930 Department of Conservation survey of Munuskong Bay State Park by C.M. Cade, C.E. Found the three record witness objects as recorded by Meyers. Record bearings to the objects are in error. Accepted corner position as found. Offset corner position prior to road reconstruction work. Replaced corner after construction was completed. Added an additional witness.

C. Description of monument for corner and accessories established to perpetuate locating the position of the corner:

(I-13) Corner is a 3/4" x 24" iron with plastic "Chippewa County Remonumentation" cap. Corner falls 1' North of centerline Gogomain Road (East-West, paved) and on the approximate centerline of Aldrich Road to the South (North-South, two track-seasonal).

Witnesses:

4" Diameter Witness Monument	North	32.92' (existing)
10" White Pine	S26°E	57.32' (existing nail)
Power Pole	S25°W	89.24' (existing nail)
8" Maple	S50°W	145.67'
12" Spruce	S78°W	147.67' (existing nail)

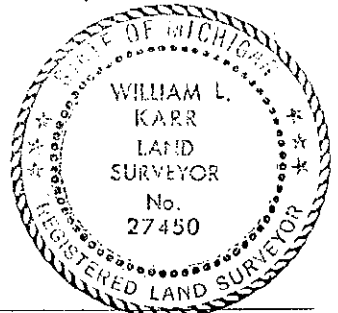

Signed by William L. Karr Date 12/29/93

Surveyor's Michigan License No. 27450

NOTE: Bearings are compass bearings corrected for declination.

Distances are to a nail in side of witness objects unless noted.