

MAR 09 1994

COMMISSION

Chippewa County Remonumentation Corner

LAND CORNER RECORDATION CERTIFICATE
Filing Requirement of Act 74, Mich. P.A. 1970

RECEIVED FOR RECORD
CHIPPEWA COUNTY
STATE OF MICHIGAN

93 DEC 29 PM 2:48

J. Roger Malott
REGISTER OF DEEDS

For corners in

Chippewa

(County)

Located In:

Corner Code ##

Table with 3 columns: Description (Public Land Survey, Property Controlling, etc.), Located In (T, R, S, T, R), and Corner Code (K-13, K-1, etc.)

Register of Deeds Stamp & File Number

4. Lot No. Recorded Plat
5. Private Claims

Grid table with columns A-M and rows 2-13, containing numerical data and handwritten notes like 'PIPE' and 'K-13'.

I, William L. Karr, in a field survey on December 6, 1993, do hereby certify that under requirements of P.A. 74, Michigan P.A. of 1970, the corner points mentioned in lines 1 and 2 above were in conformance with regulations and rules therefore as required in the current manual of survey instructions of the United States Department of the Interior, Bureau of Land Management or by a decree of a Court of Law and/or that the corner points mentioned in lines 3, 4 and 5 above were in conformance with the rules of the Michigan Board of Land Surveyors or by a Decree of a Court of Law; established, re-established, monumented, re-monumented, recovered, found as expressed below:

NOTE: Not more than 4 corners, all in the same town and range, may be recorded on this certificate.

A. Description of original monument and accessories and/or subsequent restoration:

(K-13) Section Corner Common to Sections 35, 36, 1 & 2 (T44N-R1E)

1930: C.M. Cade, C.E., Department of Conservation Survey of Munuscong Bay State Park. Found I.R. and set Witness Monument North 33' (Number 29 on survey drawing).

1960: Chippewa County Road Commission. Corner recorded in Liber 3, Page 43 of the Chippewa County Corner Records. Found Cedar post with spike.

Table listing witness monuments: 3" Iron Pipe North 33.00', TK in 10" Cedar N35°E 65.70', TK in 20" Maple N05°W 74.15'

Wskp
12/14/93

B. Description of corner evidence found and/or method applied in restoring or reestablishing corner:

(K-13) This corner is being perpetuated as part of the Chippewa County Remonumentation Program.


Found a bent 1 1/2 O.D. pipe. Found a disturbed 4" diameter concrete filled pipe with the remains of a brass tablet, 32.8' North of the bent pipe. Found both record witness objects but no evidence of tacks. Found where pipe went straight. Accepted corner position as found. Offset corner position prior to road reconstruction. Replaced corner after construction completed. Added nails to the recovered witness objects and added two additional witnesses.

C. Description of monument for corner and accessories established to perpetuate locating the position of the corner:

(K-13) Corner is a 3/4" x 24" iron with plastic "Chippewa County Remonumentation" cap. Corner falls on centerline of Gogomain Road (East-West, paved). Falls 6' West of centerline of Fairview Road to the South (North-South, paved).

Witnesses:

Table listing witnesses: 18" Maple North 74.23' (existing-new nail), 12" Cedar N30°E 65.53' (existing-new nail), Power Pole PD2/55/44 S29°E 58.45', 28" Apple Tree S42°W 133.65'

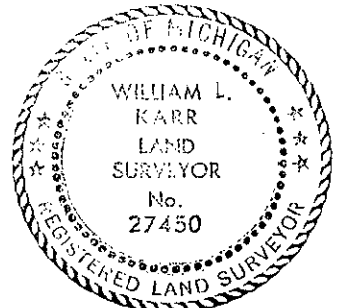

Signed by William L. Karr Date 12/23/93

Surveyor's Michigan License No. 27450

NOTE: Bearings are compass bearings corrected for declination. Distances are to a nail in side of witness objects unless noted.