


(66)

No. 8.  $\frac{1}{8}$  Corner on township line -  
 $\frac{1}{4}$  mile west of NE corner Section 2.

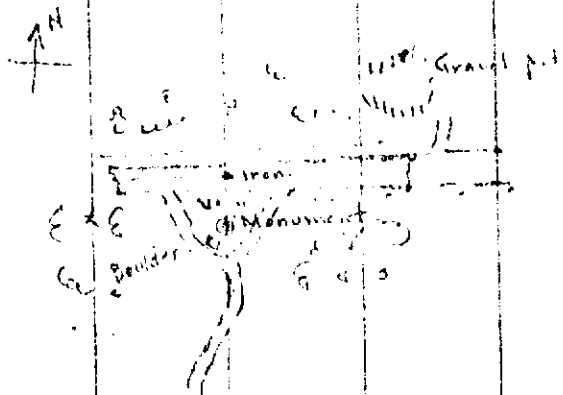

6" Spruce	S 40° E	36.4 feet
8" Birch	S 32° E	82.0
Telephone pole	S 71° E	61.2
3" Balsam	N 5° E	14.6
Standard monument	33' south of iron	
pipe in road		

No. 9.  $\frac{1}{4}$  Corner Section 2 T44N, R11E.

↑  
N

Iron pipe in road	
Standard Monument	33' South
Cut over road	60' S of road
Telephone pole	S 68° W 36.6 feet.
"	S 84° E 187.7 "
6" poplar	N 2° W 73.4 "
3" Spruce	N 37° E 52.0

No. 10