

**LAND CORNER RECORDATION CERTIFICATE**  
**Filing Requirement of Act 74, Mich. P.A. 1970**

For corners in

Chippewa

(County)

Located In:

Corner Code #

1. Public Land Survey	T	_____	R	_____	_____			
	T	_____	R	_____	_____			
	T	_____	R	_____	_____			
	T	_____	R	_____	_____			
2. Property Controlling in Section	S	<u>22</u>	T	<u>44N</u>	R	<u>1E</u>	_____	<u>3</u>
	S	<u>22</u>	T	<u>44N</u>	R	<u>1E</u>	_____	<u>4</u>
3. Miscellaneous Property in Sec.	S	_____	T	_____	R	_____	_____	_____
	S	_____	T	_____	R	_____	_____	_____

Register of Deeds Stamp & File Number

4. Lot No. \_\_\_\_\_, Recorded Plat \_\_\_\_\_  
 5. Private Claims \_\_\_\_\_

Jan 03 2007

I, Stephan J. Szyszkoski, in a field survey on \_\_\_\_\_, 19\_\_\_\_ do hereby state that under requirements of P.A. 74, Michigan P.A. of 1970, the corner points mentioned in lines 1 and 2 above were in conformance with regulations and rules therefore as required in the current manual of survey instructions of the United States Department of the Interior, Bureau of Land Management or by a decree of a Court of Law and /or that the corner points mentioned in lines 3, 4 and 5 above were in conformance with the rules of the Michigan Board of Land Surveyors or by a Decree of a Court of Law; established, re-established, monumented, recovered, found as expressed below:

NOTE: Not more than 2 corners, all in the same town and range, may be recorded on this certificate.

A	B	C	D	E	F	G	H	I	J	K	L	M
1												
2	6		5		4		3		2		1	
3												
4	7		8		9		10		11		12	
5												
6	18		17		16		15		14		13	
7												
8	19		20		21		22		23		24	
9												
10	30		29		28		27		26		25	
11												
12	31		32		33		34		35		36	
13												

A. Description of original monument and accessories and/or subsequent restoration:

(3-Sec. 22) North 1/16 corner between Sections 21 and 22. Not established in the original survey.  
 (4-Sec. 22) Northwest 1/16 corner, Section 22. Not established in the original survey.


B. Description of corner evidence found and/or method applied in restoring or reestablishing corner:

(3-Sec. 22) Established the corner midway and on the Section line between Section corner 1308.27' north and Quarter corner 1308.27' south. From the position thus established, which is 1' west of the center of a N-S road, fence lines running east and west are 6.5' south.  
 (4-Sec. 22) Established the corner at the intersection of straight lines connecting opposite 1/16 corners. From the position thus established, a fence corner post, from which fences run south and west, bears N66E, 45.0' distant.

C. Description of monument for corner and accessories established to perpetuate locating the position of the corner:

(3) Set 5/8"x24" rebar with plastic cap stamped "MI DNR PS33986". Set measuring nails in:  
 Power pole P22 2127 S60E 59.05'  
 Fence post S74E 50.4'  
 Fence post S87W 51.05'  
 10" Tamarack N28W 75.5'  
 Bearings are magnetic. Distances are to nail with tag.

(4) Set 1"IDx36" pipe with plastic cap stamped "MI DNR PS33986". Set measuring nails in:  
 Corner fence post N66E 45.0'  
 6" Ash N22E 18.04' mrkd "NW1/16 BT"  
 6" Ash S21E 17.22' do  
 7" Ash S21W 19.72' do  
 Bearings are magnetic. Distances are to nail with tag.

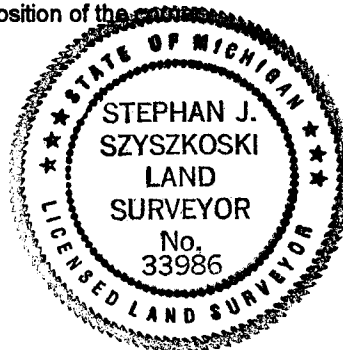

Signed by Stephan J. Szyszkoski  
 Surveyor's Michigan License No. 33986

Date 1/9/07

For the Michigan Department of Natural Resources