

**LAND CORNER RECORDATION CERTIFICATE**  
**Filing Requirement of Act 74, Mich. P.A. 1970**

For corners in

Chippewa

(County)

Located In:

Corner Code #

1. Public Land Survey	T <u>44N</u> R <u>1E</u>	<u>17</u>
	T <u>    </u> R <u>    </u>	<u>    </u>
	T <u>    </u> R <u>    </u>	<u>    </u>
	T <u>    </u> R <u>    </u>	<u>    </u>
2. Property Controlling in Section	S <u>    </u> T <u>    </u> R <u>    </u>	<u>    </u>
	S <u>    </u> T <u>    </u> R <u>    </u>	<u>    </u>
3. Miscellaneous Property in Sec.	S <u>    </u> T <u>    </u> R <u>    </u>	<u>    </u>
	S <u>    </u> T <u>    </u> R <u>    </u>	<u>    </u>

Register of Deeds Stamp & File Number

4. Lot No. \_\_\_\_\_, Recorded Plat \_\_\_\_\_  
 5. Private Claims \_\_\_\_\_

Nov 29 2006

I, Stephan J. Szyszkoski, in a field survey on \_\_\_\_\_, 19\_\_\_\_ do hereby state that under requirements of P.A. 74, Michigan P.A. of 1970, the corner points mentioned in lines 1 and 2 above were in conformance with regulations and rules therefore as required in the current manual of survey instructions of the United States Department of the Interior, Bureau of Land Management or by a decree of a Court of Law and/or that the corner points mentioned in lines 3, 4 and 5 above were in conformance with the rules of the Michigan Board of Land Surveyors or by a Decree of a Court of Law; established, re-established, monumented, recovered, found as expressed below:

NOTE: Not more than 2 corners, all in the same town and range, may be recorded on this certificate.

A	B	C	D	E	F	G	H	I	J	K	L	M
1												
2	6		5		4		3		2		1	
3												
4	7		8		9		10		11		12	
5												
6	18		17		16		15		14		13	
7								●				
8	19		20		21		22		23		24	
9												
10	30		29		28		27		26		25	
11												
12	31		32		33		34		35		36	
13												

A. Description of original monument and accessories and/or subsequent restoration:


(17) Corner common to Sections 14-15-22-23. 1845 - Established by John Mullett, Deputy Surveyor: North between Sections 22&23 ...80.00 Set post corner secs 14,15,22 & 23. Sugar 10 N59E 26 links, Sugar 10 S27W 05 links. 1894 - County Surveyor F.H.Brown states regarding Section 22: There are no original government corners on this section." Brown shows distance south = 2626' to I8 and west 2584' to H7 but no other notations about I7. 1930 - C.M.Cade, CE, for MI Dept. of Conservation found old stake and set a standard monument. Cade shows distance south = 2655.9' to I8 1972 - 1930 position perpetuated by Billy D. Buckler RLS. Mr. Buckler found Cade's 4"x48" pipe filled with concrete, buried 20" below center of N-S road and placed a 5/8"x36" to mark the position at the surface. Witnesses: 16" Cedar N74W 34.6', 17" Cedar N85E 32.0', Set Cedar post 10' east of corner. The 1930 witnesses given by Cade were: 6" Balsam S72E 37.4', 5" Balsam N32W 32.7', 8" Balsam S85W 31.3', 7" Cedar N86E 11.0' [Mr. Buckler found this last distance to be 61.3'].

B. Description of corner evidence found and/or method applied in restoring or reestablishing corner:

(17) Recovered the 1930 monument, a 4" concrete-filled, capped pipe below the westerly wheel track of a N-S road. The 1972 rebar placed by Mr. Buckler was found above, leaning. The 1972 Cedar witnesses check and are good condition. Removed the 1972 rebar, leaving the 1930 monument to mark the position of the corner.

C. Description of monument for corner and accessories established to perpetuate locating the position of the corner:

(17) Fd. 4" dia. conc-filled pipe with brass cap. Set measuring nails in:  
 17" Cedar N65W 34.7' mrkd "S15" \*  
 28" Cedar S87E 32.1' "S23" \*  
 17" Cedar N67E 46.05' mrkd "S14 NBT"  
 7" W.Birch S64E 18.35' "S23 NBT"  
 Bearings are magnetic. Distances are to nail with tag. \* denotes 1972 NBT.

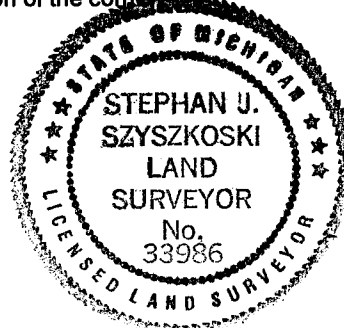

Signed by Stephan J. Szyszkoski  
 Surveyor's Michigan License No. 33986

Date 1/9/07

For the Michigan Department of Natural Resources