

SURVEY & REMONUMENTATION

NOV 07 1994

COMMISSION

LAND CORNER RECORDATION CERTIFICATE

Filing Requirement of Act 74, Mich. P.A. 1970

For corners in

Chippewa
(County)

Located in:

Corner Code #

1. Public Land Survey

T 44N R 1W A-13 Same
T 44N R 2W M-13 Corner


2. Property Controlling in Section

S _____ T _____
S _____ T _____
S _____ T _____
S _____ T _____

3. Miscellaneous Property in Sec.

4. Lot No. _____, Recorded Plat _____

5. Private Claims _____

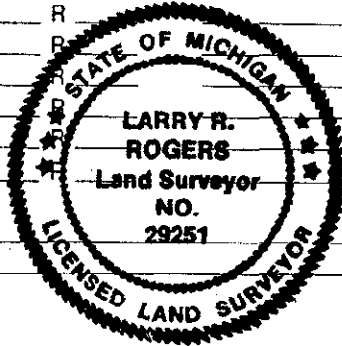

7.00 LAND CORNER
\$ 2.00 MSSR
26 OCT 94 9:41 A.M. RECEIPT# 860
RECEIVED FOR RECORD
CHIPPEWA COUNTY - STATE OF MICHIGAN
SHARON H. KENNEDY, REGISTER OF DEEDS

Register of Deeds Stamp & File Number

I, Larry R. Rogers, in a field survey on May 10, 19 94, do hereby certify that under requirements of P.A. 74, Michigan P.A. of 1970, the corner points mentioned in lines 1 and 2 above were in conformance with regulations and rules therefore as required in the current manual of survey instructions of the United States Department of the Interior, Bureau of Land Management or by a decree of a Court of Law and/or that the corner points mentioned in lines 3, 4 and 5 above were in conformance with the rules of the Michigan Board of Land Surveyors or by a Decree of a Court of Law; established, re-established, monumented, re-monumented, recovered, found as expressed below:

NOTE: Not more than 4 corners, all in the same town and range, may be recorded on this certificate.

A. Description of original monument and accessories and/or subsequent restoration:

(A-13) Southwest Corner of Section 31, T44N-R1W

1840 W.A. Burt, set corner post.

12" Spruce N18°E 7 links
10" Hemlock S82°W 32 links

1972 C. Eugene Ostling found and accepted railroad spike. Recorded in Mackinac County Corner Records at Page 39.

Power Pole N43°53'W 46.1'
Power Pole N44°39'E 45.25'
Power Pole S57°02'E 37.5'

B. Description of corner evidence found and/or method applied in restoring or reestablishing corner:

(A-13) This corner is being perpetuated as part of the Chippewa County Remonumentation Program.

Found 7/8" iron on centerline of Townline Road and 2' West of the centerline of Pea Line Road to the North. Two Ostling power poles remain and check well with corner position.

	A	B	C	D	E	F	G	H	I	J	K	L	M
2	6	5	4	3	2	1							
3													
4	7	8	9	10	11	12							
5													
6	18	17	16	15	14	13							
7													
8	19	20	21	22	23	24							
9													
10	30	29	28	27	26	25							
11													
12	31	32	33	34	35	36							



C. Description of monument for corner and accessories established to perpetuate locating the position of the corner:
(A-13) Corner is a 7/8" iron with plastic "Chippewa County Remonumentation Corner" cap. Corner falls on the centerline of Townline Road (East-West, paved) and 2' West of the centerline of Pea Line Road to the North.

Witnesses:

Power Pole (PD3/70/72) N56°E 45.27' (existing, added nail & tag)
Guy Pole S52°E 38.14'
Corner Fence Post S46°W 64.16'
Drill Hole in Top of Concrete row marker N46°W 55.04'

Signed by _____ Date 24 OCT 1994

Surveyor's Michigan License No. 29251

NOTE: Bearings are compass bearings corrected for declination.
Distances are to a nail in side of witness objects unless noted.