

NOV 07 1994

COMMISSION

LAND CORNER RECORDATION CERTIFICATE
Filing Requirement of Act 74, Mich. P.A. 1970


For corners in

Chippewa
 (County)

Located In:

Corner Code #

- 1. Public Land Survey T 44N R 1W B-13
- T R
- T R
- T R
- 2. Property Controlling S T R
- in Section S T R
- 3. Miscellaneous S T R
- Property in Sec. S T R
- 4. Lot No. _____, Recorded Plat _____
- 5. Private Claims _____

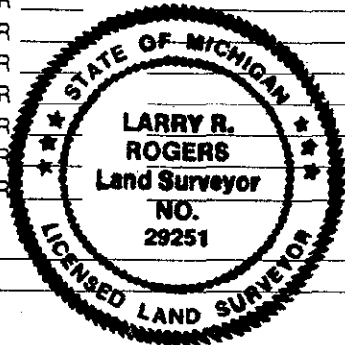

\$ 7.00 LAND CORNER
 \$ 2.00 MSSR
 26 OCT 94 9:41 A.M. RECEIPT# 860
 RECEIVED FOR RECORD
 CHIPPewa COUNTY - STATE OF MICHIGAN
 SHARON H. KENNEDY, REGISTER OF DEEDS

Register of Deeds Stamp & File Number

	A	B	C	D	E	F	G	H	I	J	K	L	M
2	6	5	4	3	2	1							
3													
4	7	8	9	10	11	12							
5													
6	18	17	16	15	14	13							
7													
8	19	20	21	22	23	24							
9													
10	30	29	28	27	26	25							
11													
12	31	32	33	34	35	36							
13													

I, Larry R. Rogers, in a field survey on May 10, 19 94, do hereby certify that under requirements of P.A. 74, Michigan P.A. of 1970, the corner points mentioned in lines 1 and 2 above were in conformance with regulations and rules therefore as required in the current manual of survey instructions of the United States Department of the Interior, Bureau of Land Management or by a decree of a Court of Law and/or that the corner points mentioned in lines 3, 4 and 5 above were in conformance with the rules of the Michigan Board of Land Surveyors or by a Decree of a Court of Law; established, re-established, monumented, re-monumented, recovered, found as expressed below:

NOTE: Not more than 4 corners, all in the same town and range, may be recorded on this certificate.

A. Description of original monument and accessories and/or subsequent restoration:

(B-13) South 1/4 Corner off Section 31, T44N-R1W

Original notes: W.A. Burt, 1840, set 1/4 section post.


Ties: 12" Fir N48E 19 links
 8" Fir N31W 31 links

1912 County Surveyor did section breakdown of Section 31.

B. Description of corner evidence found and/or method applied in restoring or reestablishing corner:

(B-13) This corner is being perpetuated as part of the Chippewa County Remonumentation Program.

Found no evidence of original corner position. Re-established corner position on line between Southwest and Southeast corners of Section 31 at a proportionate distance based on 1912 County Surveyor notes. Corner falls on extension of apparent 1/4 line fence to the North.

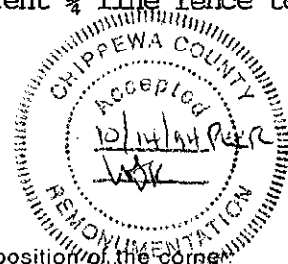

C. Description of monument for corner and accessories established to perpetuate locating the position of the corner:

(B-13) Corner is a 3/4" x 24" iron with plastic "Chippewa County Remonumentation Corner" cap. Corner falls on range of fence line to the North. Corner falls 2' North of the centerline of Townline Road.

Witnesses: Power Pole (PD3/70/65) N68°E 79.37'
 Corner Fence Post S22°E 42.51'
 Fence Post S21°W 56.24'
 End Fence Post N16°W 55.10'

Signed by [Signature] Date 24 OCT 1994
 Surveyor's Michigan License No. 29251

NOTE: Bearings are compass bearings corrected for declination.
 Distances are to a nail in side of witness objects unless noted.