


NOV 07 1994

LAND CORNER RECORDATION CERTIFICATE
Filing Requirement of Act 74, Mich. P.A. 1970

For corners in **COMMISSION**
Chippewa
 (County)

Located In: Corner Code #

- 1. Public Land Survey T 44N R 1W C-13
 T _____ R _____
 T _____ R _____
 T _____ R _____
- 2. Property Controlling S _____ T _____ R _____
 in Section S _____ T _____ R _____
- 3. Miscellaneous S _____ T _____ R _____
 Property in Sec. S _____ T _____ R _____
- 4. Lot No. _____, Recorded Plat _____
- 5. Private Claims _____

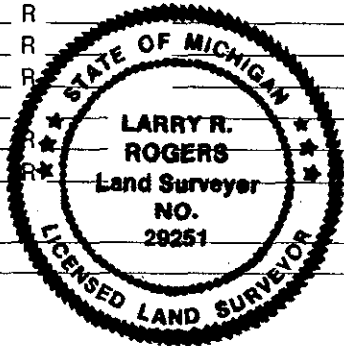

\$ 7.00 LAND CORNER
 \$ 2.00 MSSR
 26 OCT 94 9:41 A.M. RECEIPT# 860
 RECEIVED FOR RECORD
 CHIPPEWA COUNTY - STATE OF MICHIGAN
 SHARON H. KENNEDY, REGISTER OF DEEDS

Register of Deeds Stamp & File Number

	A	B	C	D	E	F	G	H	I	J	K	L	M
2	6	5	4	3	2	1							
3													
4	7	8	9	10	11	12							
5													
6	18	17	16	15	14	13							
7													
8	19	20	21	22	23	24							
9													
10	30	29	28	27	26	25							
11													
12	31	32	33	34	35	36							
13													

I, Larry R. Rogers, in a field survey on May 10, 19 94, do hereby certify that under requirements of P.A. 74, Michigan P.A. of 1970, the corner points mentioned in lines 1 and 2 above were in conformance with regulations and rules therefore as required in the current manual of survey instructions of the United States Department of the Interior, Bureau of Land Management or by a decree of a Court of Law and/or that the corner points mentioned in lines 3, 4 and 5 above were in conformance with the rules of the Michigan Board of Land Surveyors or by a Decree of a Court of Law; established, re-established, monumented, re-monumented, recovered, found as expressed below:

NOTE: Not more than 4 corners, all in the same town and range, may be recorded on this certificate.

A. Description of original monument and accessories and/or subsequent restoration:

(C-13) Southeast Corner of Section 31, T44N-R1W


Original notes: W.A. Burt, 1840, set 1/4 section post.

Ties: 10" Fir N40E 41 links
 10" Fir N40W 24 links

B. Description of corner evidence found and/or method applied in restoring or reestablishing corner:

(C-13) This corner is being perpetuated as part of the Chippewa County Remonumentation Program.

Found no evidence of original corner position. Found a 5/8" iron 18" below top of pavement. Falls 1.5' North of the centerline of Townline Road and 2' West of the centerline of McCabe Road to the North. Distance to the South 1/4 Corner of Section 31 is 2642.5' (1912 County Surveyor 2643'). Accepted position and replaced with 3/4" x 24" iron above found iron.

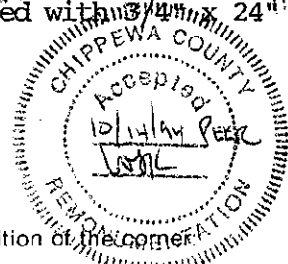

C. Description of monument for corner and accessories established to perpetuate locating the position of the corner:

(C-13) Corner is a 3/4" x 24" iron with plastic "Chippewa County Remonumentation Corner" cap. Corner falls 1.5' North of the centerline of Townline Road and 2' West of the centerline of McCabe Road to the North.

Witnesses: Power Pole (PD3/70/57) N43°E 43.79'
 Corner Fence Post S36°E 69.06'
 14" Burr Oak (blazed) S59°W 44.47'
 Corner fence Post N46°W 49.40'

Signed by [Signature] Date 24 OCT 1994
 Surveyor's Michigan License No. 29251