

NOV 07 1994

COMMISSION


LAND CORNER RECORDATION CERTIFICATE
Filing Requirement of Act 74, Mich. P.A. 1970

For corners in

Chippewa (County)

Located in: Corner Code #

- 1. Public Land Survey T 44N R 1W D-13
2. Property Controlling in Section S T
3. Miscellaneous Property in Sec. S T
4. Lot No. Recorded Plat
5. Private Claims

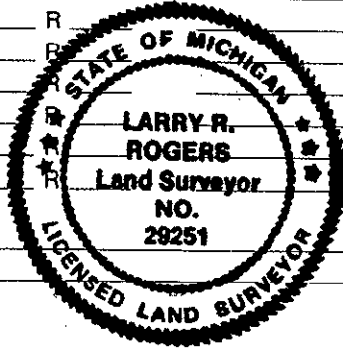

\$ 7.00 LAND CORNER
\$ 2.00 MSSR
26 OCT 94 9:42 A.M. RECEIPT# 860
RECEIVED FOR RECORD
CHIPPEWA COUNTY - STATE OF MICHIGAN
SHARON H. KENNEDY, REGISTER OF DEEDS

Register of Deeds Stamp & File Number

Grid table with columns A-M and rows 2-13. Contains handwritten markings 'N', 'W', 'R', 'L' and a dot at row 13, column C.

I, Larry R. Rogers, in a field survey on May 10, 1994, do hereby certify that under requirements of P.A. 74, Michigan P.A. of 1970, the corner points mentioned in lines 1 and 2 above were in conformance with regulations and rules therefore as required in the current manual of survey instructions of the United States Department of the Interior, Bureau of Land Management or by a decree of a Court of Law and/or that the corner points mentioned in lines 3, 4 and 5 above were in conformance with the rules of the Michigan Board of Land Surveyors or by a Decree of a Court of Law; established, re-established, monumented, re-monumented, recovered, found as expressed below:

NOTE: Not more than 4 corners, all in the same town and range, may be recorded on this certificate.

A. Description of original monument and accessories and/or subsequent restoration: (D-13) South 1/4 Corner of Section 32 (Standard Corner) T44N-R1W

Original notes: W.A. Burt, 1840, set 1/4 section post.


Ties: 10" Fir N43E 39 links
10" Lynn N35W 8 links

B. Description of corner evidence found and/or method applied in restoring or reestablishing corner: (D-13) This corner is being perpetuated as part of the Chippewa County Remonumentation Program.

Found no evidence of original corner position. Found PK nail in the centerline of Townline Road and on extension of apparent 1/4 line fence to the North. Distances to section corners to the East and West match County Surveyor notes reasonably well. Accepted corner position and replace PK nail with 3/4" x 24" iron with plastic Chippewa County Remonumentation Corner cap. Corner falls 10.5' West of the extension off cemetery fence line to the South.

C. Description of monument for corner and accessories established to perpetuate locating the position of the corner: (D-13) Corner is a 3/4" x 24" iron with plastic "Chippewa County Remonumentation Corner" cap. Corner falls in the centerline of Townline Road and on extension of fence line to the North.

Witnesses: Power Pole (PD2/70/50) N29°E 46.63'
Chiseled "x" on top of metal corner fence post S05°E 35.29'
4" Spruce S67°W 106.71'
Fence Post N80°W 47.25'

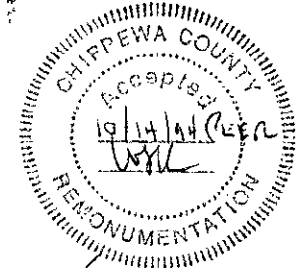

Signed by [Signature] Date 24 OCT 1994

Surveyor's Michigan License No. 29251

NOTE: Bearings are compass bearings corrected for declination. Distances are to a nail in side of witness objects unless noted.