

NOV 07 1994

COMMISSION

LAND CORNER RECORDATION CERTIFICATE

Filing Requirement of Act 74, Mich. P.A. 1970

For corners in

Chippewa

(County)

Located In:

Corner Code #

1. Public Land Survey

T 44N R 1W F-13

T R

T R

T

2. Property Controlling in Section

S T

S T

3. Miscellaneous


S T

Property in Sec.

S T

4. Lot No. , Recorded Plat

5. Private Claims

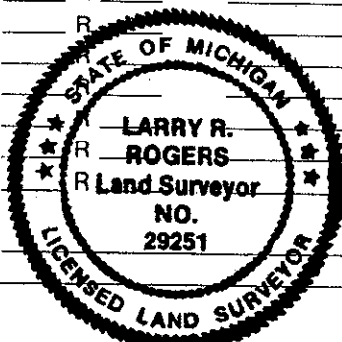

\$ 7.00 LAND CORNER

\$ 2.00 MSSR

26 OCT 94 9:42 A.M. RECEIPT# 860

RECEIVED FOR RECORD

CHIPPEWA COUNTY - STATE OF MICHIGAN

SHARON H. KENNEDY, REGISTER OF DEEDS

Register of Deeds Stamp & File Number

Grid table with columns A-M and rows 2-13. Contains handwritten numbers and a small 'N' in cell 10-11.

Larry R. Rogers in a field survey on May 10, 1994

do hereby certify that under requirements of P.A. 74, Michigan P.A. of 1970, the corner points mentioned in lines 1 and 2 above were in conformance with regulations and rules therefore as required in the current manual of survey instructions of the United States Department of the Interior, Bureau of Land Management or by a decree of a Court of Law and/or that the corner points mentioned in lines 3, 4 and 5 above were in conformance with the rules of the Michigan Board of Land Surveyors or by a Decree of a Court of Law; established, re-established, monumented, re-monumented, recovered, found as expressed below:

NOTE: Not more than 4 corners, all in the same town and range, may be recorded on this certificate.

A. Description of original monument and accessories and/or subsequent restoration:

(F-13) South 1/4 Corner of Section 33 (Standard Corner) T44N-R1W

William L. Karr, P.S. #27450, found no evidence of original corner. Set 1/2" iron with L.S. cap #27450 midway and on line between the Southeast and Southwest corners of Section 33 as recorded in Liber 6, Page 125 of the Chippewa County Corner Records.

Table with 4 columns: Ties, Fence Post, Power Pole (64), Closing Corner. Values include bearings (S21E, N28W, East) and distances (52.26', 38.53', 20.1' (20.13' GLO)).

B. Description of corner evidence found and/or method applied in restoring or reestablishing corner:

(F-13) This corner is being perpetuated as part of the Chippewa County Remonumentation Program.

Found 1/2" iron on centerline of Townline Road. Found witness Power Pole (64) N28W 38.53'. Found Closing Corner East 20.1'. Accepted corner position as found and rewitnessed.



C. Description of monument for corner and accessories established to perpetuate locating the position of the corner: (F-13) Corner is a 1/2" iron on centerline of Townline Road. Corner falls on extension of fence line to the North.

Witnesses:

Table with 3 columns: Witness, Bearing, Distance. Includes entries for Fence Post (S10°E 48.43', S19°W 49.46', S60°W 88.09'), Power Pole (N28°W 38.46' (existing, added nail & tag)), and Closing Corner (S85°E 20.10 (20.13' GLO)).

Signed by [Signature]

Date 24 OCT 1994

Surveyor's Michigan License No. 29251

NOTE: Bearings are compass bearings corrected for declination. Distances are to a nail in side of witness objects unless noted.