

NOV 07 1994

COMMISSION

LAND CORNER RECORDATION CERTIFICATE
Filing Requirement of Act 74, Mich. P.A. 1970


For corners in

Chippewa
 (County)

Located In:

Corner Code #

- | | | |
|---------------------------------------|--------------------------|------|
| 1. Public Land Survey | T <u>44N</u> R <u>1W</u> | G-13 |
| | T _____ R _____ | |
| | T _____ R _____ | |
| | T _____ R _____ | |
| 2. Property Controlling in Section | S _____ T _____ | |
| | S _____ T _____ | |
| 3. Miscellaneous Property in Sec. | S _____ T _____ | |
| | S _____ T _____ | |
| 4. Lot No. _____, Recorded Plat _____ | | |
| 5. Private Claims _____ | | |

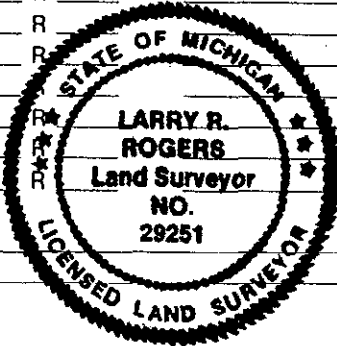

\$ 7.00 LAND CORNER
 \$ 2.00 MSSR
 26 OCT 94 9:43 A.M. RECEIPT# 060
 RECEIVED FOR RECORD
 CHIPPEWA COUNTY - STATE OF MICHIGAN
 SHARON H. KENNEDY, REGISTER OF DEEDS

Register of Deeds Stamp & File Number

	A	B	C	D	E	F	G	H	I	J	K	L	M
2	6	5	4	3	2	1							
3													
4	7	8	9	10	11	12							
5													
6	18	17	16	15	14	13							
7													
8	19	20	21	22	23	24							
9													
10	30	29	28	27	26	25							
11													
12	31	32	33	34	35	36							
13													

I, Larry R. Rogers, in a field survey on May 10, 19 94, do hereby certify that under requirements of P.A. 74, Michigan P.A. of 1970, the corner points mentioned in lines 1 and 2 above were in conformance with regulations and rules therefore as required in the current manual of survey instructions of the United States Department of the Interior, Bureau of Land Management or by a decree of a Court of Law and/or that the corner points mentioned in lines 3, 4 and 5 above were in conformance with the rules of the Michigan Board of Land Surveyors or by a Decree of a Court of Law; established, re-established, monumented, re-monumented, recovered, found as expressed below:

NOTE: Not more than 4 corners, all in the same town and range, may be recorded on this certificate.

A. Description of original monument and accessories and/or subsequent restoration:
(G-13) Standard Corner between Sections 33 and 34, T44N-R1W


Original notes: W.A. Burt, 1840, set post corner Sections 33 & 34

Ties: 10" Spruce	N69E	31 links
7" Spruce	N66W	34 links
Closing Corner Sections 3 & 4	East	27.06 feet

B. Description of corner evidence found and/or method applied in restoring or reestablishing corner:

(G-13) This corner is being perpetuated as part of the Chippewa County Remonumentation Program.

Found no evidence of original corner position. Found 1 1/2" iron bar 0.7 feet South of the centerline of Townline Road. Iron bar was previously used in several surveys by others. Accepted corner position as found.

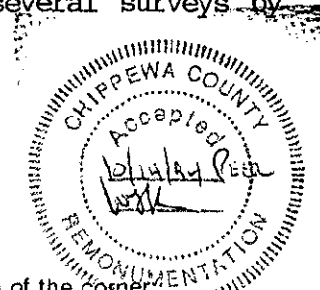

C. Description of monument for corner and accessories established to perpetuate locating the position of the corner:
(G-13) Corner is a 1 1/2" iron bar. Corner falls 0.7 feet South of the centerline of Townline Road.

Witnesses:

Power Pole	N83°E	248.94'
"V" in West End of 24" CMP	S06°E	55.35'
Power Pole (PD3/70/30)	N83°W	254.24'
Power Pole (PD3/70/29)	N57°W	57.64'

Signed by

Date

24 OCT 1994

Surveyor's Michigan License No. 29251

NOTE: Bearings are compass bearings corrected for declination.
 Distances are to a nail in side of witness objects unless noted.