

SURVEY & REMONUMENTATION

APR 26 1995

CHIPPEWA COUNTY REMONUMENTATION CORNER

COMMISSION

LAND CORNER RECORDATION CERTIFICATE

Filing Requirement of Act 74, Mich. P.A. 1970

For corners in Chippewa

Located In: _____ Corner Code # _____

(County) _____

1. Public Land Survey T 44N R 1W H-1
 T _____ R _____
 T _____ R _____
 T _____ R _____

2. Property Controlling S _____ T _____ R _____
 in Section S _____ T _____ R _____


3. Miscellaneous S _____ T _____ R _____
 Property in Sec. S _____ T _____ R _____

4. Lot No. _____, Recorded Plat _____

5. Private Claims _____

\$ 7.00 LAND CORNER
 \$ 2.00 MSSR
 5 DEC 94 12:33 P.M. RECEIPT# 1520
 RECEIVED FOR RECORD
 CHIPPEWA COUNTY - STATE OF MICHIGAN
 SHARON H. KENNEDY, REGISTER OF DEEDS

Register of Deeds Stamp & File Number

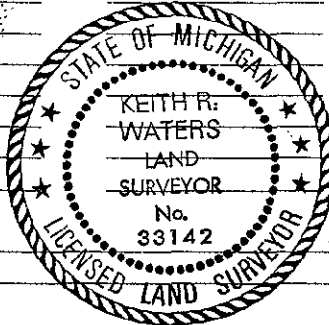

	A	B	C	D	E	F	G	H	I	J	K	L	M
2	6		5		4		3		2		1		
3													
4	7		8		9		10		11		12		
5													
6	18		17		16		15		14		13		
7													
8	19		20		21		22		23		24		
9													
10	30		29		28		27		26		25		
11													
12	31		32		33		34		35		36		
13													

Keith R. Waters May 25 94

I, _____ in a field survey on _____, 19____ do hereby certify that under requirements of P.A. 74, Michigan P.A. of 1970, the corner points mentioned in lines 1 and 2 above were in conformance with regulations and rules therefore as required in the current manual of survey instructions of the United States Department of the Interior, Bureau of Land Management or by a decree of a Court of Law and/or that the corner points mentioned in lines 3, 4 and 5 above were in conformance with the rules of the Michigan Board of Land Surveyors or by a Decree of a Court of Law; established, re-established, monumented, re-monumented, recovered, found as expressed below:

NOTE: Not more than 4 corners, all in the same town and range, may be recorded on this certificate.

A. Description of original monument and accessories and/or subsequent restoration:

H-1 North 1/4 Corner of Section 3, T44N, R1W

Corner was not established in the original survey.

Found no evidence of subsequent establishment of this corner.

B. Description of corner evidence found and/or method applied in restoring or reestablishing corner:

H-1 (T44N, R1W)

This corner is being established as part of the Chippewa County Remonumentation Program.

Established corner equidistant between closing section corner 2648.74 feet east and common section corner 2648.74 feet west, on line between the standard section corner 2635.53 feet east and the south 1/4 corner of Section 34, T45N, R1W 8.94 feet west. Corner falls in the approximate centerline of an east-west dirt road, 9 feet east of a fence line to the north.

C. Description of monument for corner and accessories established to perpetuate locating the position of the corner:

H-1 (T44N, R1W)

Corner is a 3/4" x 24" rebar with a plastic Chippewa County Remonumentation cap in the centerline of an east-west dirt road, 9 feet east of a fence line to the north. Witnesses:

- Corner Fence Post, N17°E 28.44'
- 8" Red Pine, S37°E 70.22'
- 10" Red Pine, S02°E 46.37'
- 14" Red Pine, S49°W 84.76'

Note: Distances are to a nail and tag in the side of witness object. Trees are blazed and painted. Bearings are compass bearings corrected for declination.

Signed by Keith R. Waters

Date 12-1-94

Surveyor's Michigan License No. 33142

