

NOV 07 1994

LAND CORNER RECORDATION CERTIFICATE
Filing Requirement of Act 74, Mich. P.A. 1970

COMMISSION

For corners in

Chippewa
 (County)

Located In:

Corner Code #

1. Public Land Survey

T 44N R 1W H-13

T _____ R _____

T _____ R _____

T _____ R _____

2. Property Controlling in Section

S _____ T _____

S _____ T _____


3. Miscellaneous Property in Sec.

S _____ T _____

S _____ T _____

4. Lot No. _____, Recorded Plat _____

5. Private Claims _____

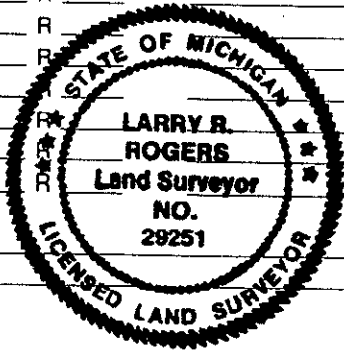

\$ 7.00 LAND CORNER
 \$ 2.00 MSSR
 26 OCT 94 9:43 A.M. RECEIPT# 843
 RECEIVED FOR RECORD
 CHIPPEWA COUNTY - STATE OF MICHIGAN
 SHARON H. KENNEDY, REGISTER OF DEEDS

Register of Deeds Stamp & File Number

	A	B	C	D	E	F	G	H	I	J	K	L	M
2	6	5											
3													
4	7	8	9	10	11	12							
5													
6	16	17	18	15	14	13							
7													
8	19	20	21	22	23	24							
9													
10	30	29	28	27	26	25							
11													
12	31	32	33	34	35	36							
13													

I, Larry R. Rogers, in a field survey on May 10, 19 94, do hereby certify that under requirements of P.A. 74, Michigan P.A. of 1970, the corner points mentioned in lines 1 and 2 above were in conformance with regulations and rules therefore as required in the current manual of survey instructions of the United States Department of the Interior, Bureau of Land Management or by a decree of a Court of Law and/or that the corner points mentioned in lines 3, 4 and 5 above were in conformance with the rules of the Michigan Board of Land Surveyors or by a Decree of a Court of Law; established, re-established, monumented, re-monumented, recovered, found as expressed below:

NOTE: Not more than 4 corners, all in the same town and range, may be recorded on this certificate.

A. Description of original monument and accessories and/or subsequent restoration:

(H-13) South 1/4 Corner of Section 34 (Standard Corner) T44N-R1W

Original notes: W.A. Burt, 1840, set 1/4 Section post.

Ties: 8" Spruce N56E 12 links
 10" Spruce N30W 17 links

B. Description of corner evidence found and/or method applied in restoring or reestablishing corner:

(H-13) This corner is being perpetuated as part of the Chippewa County Remonumentation Program.


Found no evidence of original corner position. Found 1/2" iron pin in the centerline of Townline Road, 32 feet South and 31 feet North of right-of-way fences, on extension of apparent 1/2 line fence to the North and 24 feet West of extension of apparent 1/2 line fence to the South. (GLO falling was 22.44). Accepted corner position as found.

C. Description of monument for corner and accessories established to perpetuate locating the position of the corner:

(H-13) Corner is a 1/2" iron. Corner falls in centerline of Townline Road (East-West, paved). Corner falls on fence line to the North and 24' West of fence line to the South.

Witnesses:

Fence Post N25°E 32.58'
 Power Pole N83°E 223.38'
 Corner Fence Post S37°E 38.36'
 Power Pole N67°W 72.72'

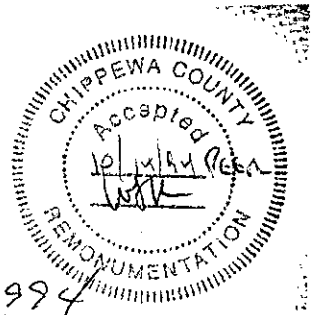

Signed by _____

Date 24 OCT 1994

Surveyor's Michigan License No. 29251

NOTE: Bearings are compass bearings corrected for declination.
 Distances are to a nail in side of witness objects unless noted.