

**SURVEY &  
REMONUMENTATION**

CHIPPEWA COUNTY REMONUMENTATION CORNER

APR 26 1995

**LAND CORNER RECORDATION CERTIFICATE**  
Filing Requirement of Act 74, Mich. P.A. 1970

**COMMISSION**

For corners in  
Chippewa

(County)

Located In:

Corner Code I-7

- |                                       |                          |            |
|---------------------------------------|--------------------------|------------|
| 1. Public Land Survey                 | T <u>44N</u> R <u>1W</u> | <u>I-7</u> |
|                                       | T _____ R _____          | _____      |
|                                       | T _____ R _____          | _____      |
|                                       | T _____ R _____          | _____      |
| 2. Property Controlling<br>in Section | S _____ T _____ R _____  | _____      |
|                                       | S _____ T _____ R _____  | _____      |
| 3. Miscellaneous<br>Property in Sec.  | S _____ T _____ R _____  | _____      |
|                                       | S _____ T _____ R _____  | _____      |

\$ 7.00 LAND CORNER  
\$ 2.00 MSSR  
24 OCT 94 3:46 P.M. RECEIPT# 831  
RECEIVED FOR RECORD  
CHIPPEWA COUNTY - STATE OF MICHIGAN  
SHARON H. KENNEDY, REGISTER OF DEEDS

Register of Deeds Stamp & File Number

4. Lot No. \_\_\_\_\_, Recorded Plat \_\_\_\_\_  
5. Private Claims \_\_\_\_\_

I, Keith R. Waters in a field survey on August 10, 19 93, do hereby certify that under requirements of P.A. 74, Michigan P.A. of 1970, the corner points mentioned in lines 1 and 2 above were in conformance with regulations and rules therefore as required in the current manual of survey instructions of the United States Department of the Interior, Bureau of Land Management or by a decree of a Court of Law and/or that the corner points mentioned in lines 3, 4 and 5 above were in conformance with the rules of the Michigan Board of Land Surveyors or by a Decree of a Court of Law; established, re-established, monumented, re-monumented, recovered, found as expressed below:

**NOTE: Not more than 4 corners, all in the same town and range, may be recorded on this certificate.**

- A. Description of original monument and accessories and/or subsequent restoration:  
I-7 Corner Common to Sections 14,15,22, & 23, T44N, R1W  
  
Original ties to post: Spruce 12, N28°E 12 links  
Hemlock 10, S25°W 09 links

Sketches in County Surveyor's office show distances of 5280 feet and 5213 feet from this corner to Section corners east and south, respectively.

- B. Description of corner evidence found and/or method applied in restoring or reestablishing corner:



I-7 (T44N, R1W)  
This corner is being re-established as part of the Chippewa County Remonumentation Program.  
Found no evidence of corner or its accessories. Re-established corner at record County Surveyor distances from Section corners 1 mile east and 1 mile south, as mentioned above. Corner falls in the approximate centerline of a north-south 2-track road. North-south position fits well with remains of right-of-way fences along an old east-west road between Sections 14 and 23.

- C. Description of monument for corner and accessories established to perpetuate locating the position of the corner:

I-7 (T44N, R1W)  
Corner is a 3/4" x 24" rebar with 3 1/4" aluminum Chippewa County Remonumentation cap in the approximate centerline of a north-south 2-track road. Witnesses:

- 16" Spruce, N57°E 26.42'
- 4" Balsam Poplar, S75°E 28.34'
- 6" White Birch, S50°E 68.55'
- 5" Balsam Poplar, S30°E 36.26'

Note: Distances are to a nail and tag in the side of the tree. Trees are blazed painted. Bearings are compass bearings corrected for declination. Distances are measured with EDM.

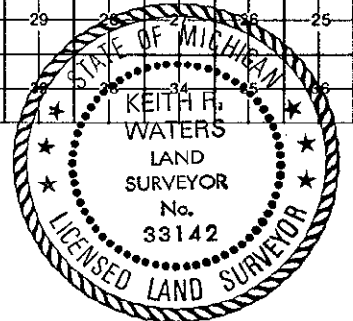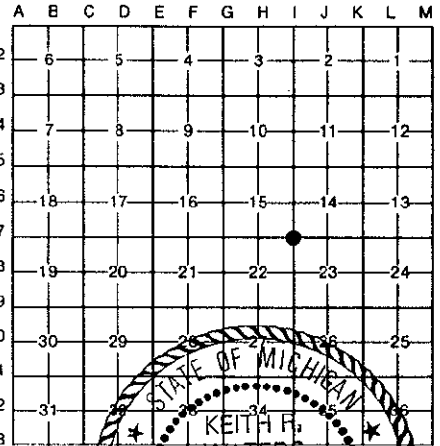

Signed by Keith R. Waters  
Surveyor's Michigan License No. 33142

Date 10-18-94

