

SURVEY & REMONUMENTATION

APR 26 1995

CHIPPEWA COUNTY REMONUMENTATION CORNER


COMMISSION

LAND CORNER RECORDATION CERTIFICATE
Filing Requirement of Act 74, Mich. P.A. 1970

For corners in
Chippewa
(County)

Located In: _____ Corner Code # _____

- 1. Public Land Survey T 44N R 1W K-1
T _____ R _____
T _____ R _____
T _____ R _____
- 2. Property Controlling S _____ T _____ R _____
in Section S _____ T _____ R _____
- 3. Miscellaneous S _____ T _____ R _____
Property in Sec. S _____ T _____ R _____
- 4. Lot No. _____, Recorded Plat _____
- 5. Private Claims _____

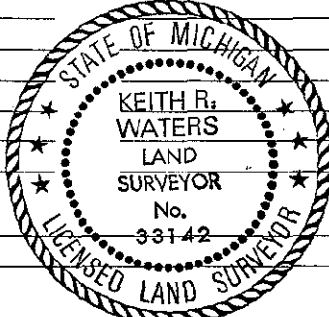

\$ 7.00 LAND CORNER
\$ 2.00 MSSR
5 DEC 94 12:32 P.M. RECEIPT# 1520
RECEIVED FOR RECORD
CHIPPEWA COUNTY - STATE OF MICHIGAN
SHARON H. KENNEDY, REGISTER OF DEEDS
Register of Deeds Stamp & File Number

	A	B	C	D	E	F	G	H	I	J	K	L	M
2	6	5	4	3	2	1							
3													
4	7	8	9	10	11	12							
5													
6	18	17	16	15	14	13							
7													
8	19	20	21	22	23	24							
9													
10	30	29	28	27	26	25							
11													
12	31	32	33	34	35	36							
13													

I, Keith R. Waters in a field survey on November 7, 19 94, do hereby certify that under requirements of P.A. 74, Michigan P.A. of 1970, the corner points mentioned in lines 1 and 2 above were in conformance with regulations and rules therefore as required in the current manual of survey instructions of the United States Department of the Interior, Bureau of Land Management or by a decree of a Court of Law and/or that the corner points mentioned in lines 3, 4 and 5 above were in conformance with the rules of the Michigan Board of Land Surveyors or by a Decree of a Court of Law; established, re-established, monumented, re-monumented, recovered, found as expressed below:

NOTE: Not more than 4 corners, all in the same town and range, may be recorded on this certificate.

A. Description of original monument and accessories and/or subsequent restoration:

K-1 Corner Common to Sections 1 & 2, on North Boundary of T44N, R1W. (Closing Corner on Township Line).
Original ties to post: Birch 10, S55°E 27 links - Hemlock 12, S75°W 08 links
1990 - As recorded in liber 7, page 313, Chippewa County corner records, by William L. Karr, P.S. 27450. Set ½" x 48" iron w/cap #27450.
Witnesses: 8" Balsam Fir, N07°E 23.96' 7" Spruce, N75°E 19.18'
7" Spruce, S17°E 19.33' Standard Corner, WEST 8.58'

B. Description of corner evidence found and/or method applied in restoring or reestablishing corner:

K-1 (T44N, R1W)
This corner is being perpetuated as part of the Chippewa County Remonumentation Program.
Found a ½" iron with cap #27450 and all witness objects as shown in liber 7, page 313. Corner was established at record G.L.O. distance (8.58 feet) east of the standard corner common to Sections 35 & 36, T45N, R1W, on line with the township corner to the east. Accepted corner as found and set new measuring nails in the sides of the bearing trees.

C. Description of monument for corner and accessories established to perpetuate locating the position of the corner:

K-1 (T44N, R1W)
Corner is ½" x 48" iron with plastic cap #27450. Witnesses:
8" Balsam Fir, N07°E 24.06' Note: Distances are to a nail and tag in the side of the tree. Trees are blazed and painted. Bearings are compass bearings corrected for declination.
7" Spruce, N75°E 19.25'
7" Spruce, S17°E 19.27'
½" Iron w/cap 27450 at Standard Corner, WEST 8.58'

Signed by Keith R. Waters Date 12-1-94

Surveyor's Michigan License No. 33142

